

KANSAS

Rice County

FORM 51 IOM 12-46 PETROL

Section 25 Township 19 Range 6-W

Well No. 3 Anderson


Company Mallard Drlg. Co.

Bornholdt Pool

NORTH

WEST

EAST

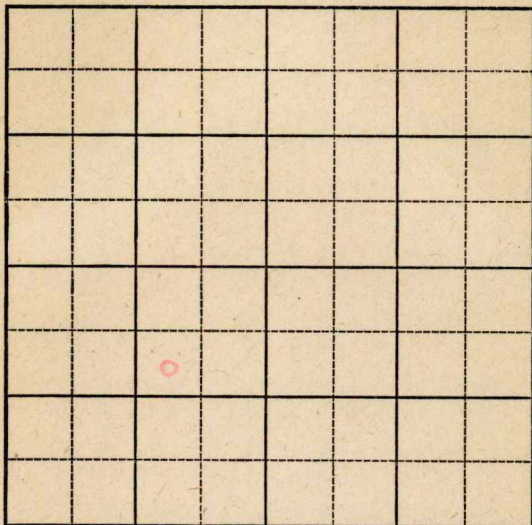

SOUTH

KANSAS

Rice



Sec. 25 Twp. 19 R. 6-W

Well No. #3 Anderson Farm

Mallard Drlg Company

Bornholdt Pool


 Ft. from N. Line

330 Ft. from S. Line

990 Ft. from E. Line

 Ft. from W. Line

SW SE SW

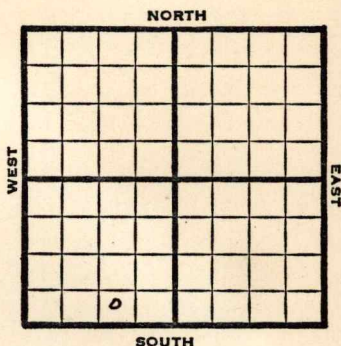

1947

E1 1593'

REPORT

7/9

8" @ 132'
Drlg 465'

7/16

Chat 3323-29' TD
5" @ 3324'
RUST

7/22

TD 3356'
950' oil.

7/29

"

8/6

Chat 3323'
5" @ 3324'
Pump 165 Pot.
40 Gr.
T.D. 3356'
Complete

COMPLETED

Map No. _____ Sec. 25 Twp. 19 R. 6W

Well No. 3 Anderson

Mallard Drlg. Company

FIRST REPORT

Contractor

SW SE SW

SECTION PLAT

_____ Ft. from N. Line

330 Ft. from S. Line

990 Ft. from E. Line

_____ Ft. from W. Line

Rice County

Location _____

Rig up _____

Drilling and Remarks:

8" @ 132

drlg. 465

RECORD

Cased _____ in., _____ ft.

Sand _____

Gas _____

Oil _____

Total Depth _____

PRODUCTION

1st 24 hrs. Nat. _____

1st 24 hrs. after shot _____

Gas _____ Cu. Ft.

Dry Hole _____

Abandoned _____

Date

JUL 9 1947

19

S. J. LEWIS


Scout

Map No. 48 Sec. 25 Twp. 19 R. 6WWell No. 3 AndersonMallard Drlg. Company

COMPLETE

Contractor

SW SE SW

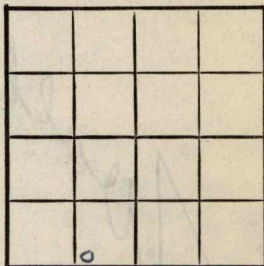2/1/59
SECTION PLAT Ft. from N. Line330 Ft. from S. Line990 Ft. from E. Line Ft. from W. Line

Rice County

Location Rig up

Drilling and Remarks:

Chas 8323
5" @ 3324
Pump 165

40° SW

RECORD

Cased in., ft.Sand Gas Oil Total Depth 3356

PRODUCTION

1st 24 hrs. Nat. 1st 24 hrs. after shot Gas Cu. Ft.Dry Hole Abandoned

Date

AUG 6 1947 19S. J. LEWIS Scout