

KANSAS


FORM 51 5M 4-41 PETROL

Rice

Section 25 Township 19 Range 6-W

Well No. #2 Mattson

Company R. D. Shade et al

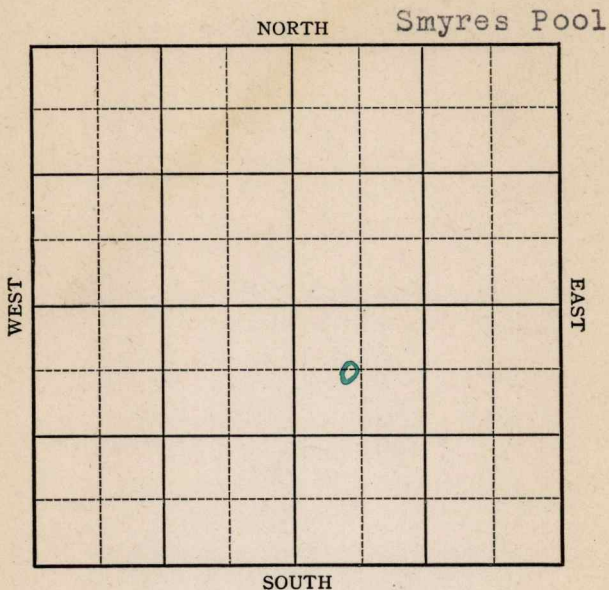

KANSAS

Rice

Sec. 25 Twp. 19 R. 6-W

Well No. #2 Mattson Farm

R. S. Shade et al _____ Company

(Smyres)


660 Ft. from N. Line

_____ Ft. from S. Line

_____ Ft. from E. Line

515 Ft. from W. Line

Elw. 1607

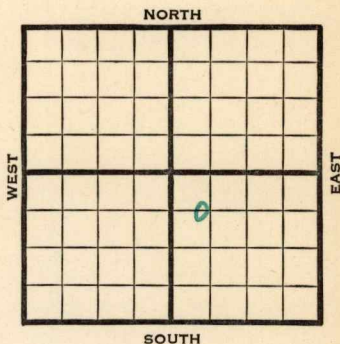

1942

REPORT

6/10	Rotary.
------	---------

6/17	8" - 183' Drlg. 2315'
------	-----------------------

6/24	Cong. 3352'	Miss. 3402'	T.D. 3413'
------	-------------	-------------	------------

5" - 3410' RUST.

7/1 Miss. 3402' (Corrected) 5" - 3404'

T.D. 3418' H.F.O.

7/8	Miss. 3402!
-----	-------------

5" - 3404'

T.D. 3418'

Potential 324 bbls., pump.

37. Gravity

COMPLETED

Rice

Map No. 78 Sec. 25 Twp. 19 R. 6WWell No. 2 Mattson

R. S. Shade Etal.

Company

FIRST REPORT

Contractor

C NW SE

SECTION PLAT

660 Ft. from N. Line

_____ Ft. from S. Line

_____ Ft. from E. Line

515 Ft. from W. Line

		b	

SMYRES POOL

Location _____

Rig up _____

Drilling and Remarks:

Rotary

RECORD

Cased _____ in., _____ ft.

Sand _____

Gas _____

Oil _____

Total Depth _____

PRODUCTION

1st 24 hrs. Nat. _____

1st 24 hrs. after shot _____

Gas _____ Cu. Ft.

Dry Hole _____

Abandoned _____

Date

JUN 10 1942

19

S. J. LEWIS

Scout

Rice


KANSAS

Map No. 4P Sec. 25 Twp. 19 R. 6WWell No. 2 MattsonR. S. Shade et al. Company**COMPLETED**

Contractor

C NW SE

SECTION PLAT

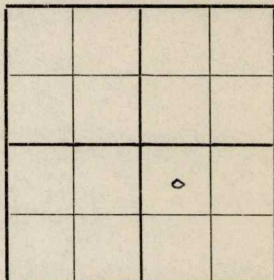660 Ft. from N. Line

_____ Ft. from S. Line

_____ Ft. from E. Line

515 Ft. from W. LineSMYRES POOL

Location _____

Rig up _____

Drilling and Remarks:

*Miss 3402**5" C 3404**Pump 32402X**370 gr*

RECORD

Cased _____ in., _____ ft.

Sand _____

Gas _____

Oil _____

Total Depth 3415

PRODUCTION

1st 24 hrs. Nat. _____

1st 24 hrs. after shot _____

Gas _____ Cu. Ft.

Dry Hole _____

Abandoned _____

Date

JUL 8 1942 19S. J. LEWIS

Scout