
Rush

3 18S KANSAS 17W

SECTION TOWNSHIP RANGE

WELL NO. #1 Timken

COMPANY Aylward Drlg.

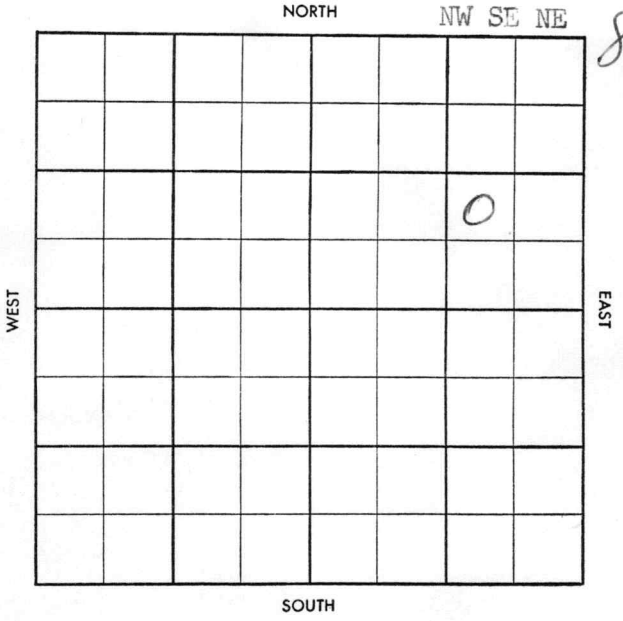

FORM 504-3 SUNRAY

S-513-A

CO. Rush ELEV.

SEC. 3 TWP. 18 RGE. 17W

COMPANY Aylward Drlg. NO. 1

FARM Timken

LOC. NW SE NE 950' EL

Pan American FO

GEOL.

CONTR. Co. tools

POOL Lohrey

SPUD 10-9-57

8" @ 1070/450

drlg. 1882

FIRST REPORT

NOV 13 '57

CO. LSE. NO. SEC. TWP. RGE.

~~Lohrey~~

S—513-A

CO. ~~Rush~~ ELEV. 1999 DF

SEC. ~~3~~ TWP. 18 RGE. 17W

COMPANY Aylward Drlg. NO. 1

DEC 18 '57 — COMPLETE

FARM Timken

LOC. NW SE NE 950' EL
Pan American FO

GEOL.

CONTR. Co. tools

POOL Lohrey

SPUD 10-9-57

8" @ 1070/450

dmlr. 1382

NOV 20 '57

Congl 3560

PreCam 3618

~~Back DST~~

GW 3653

DST 3521 - 3663 75"
G/14" spray in 45" ga
7.000 mcf/45" 5.300 mcf/75
rec 10' SGCM FP 645-925
BHP 1050 - 1070/30" RTD 3663
Log Tops L 3295 Bkc 3524
PreCam 3596 GW 3653
LTD 3662 ~~run pipe~~
5½ 3662½ WOC
CO 60/ 3615-30

40/ 3557-67 10/ 3568-73
ga 12.000 mcf - WW SF

SI gas well

3568-73

LSE. NO. SEC. TWP. RGE. CO.