
FORM 51 25M 8-50 WESTERN Rice KANSAS

Section 35 Township 19 Range 6 W

Well No. # 1 Smyers

Company Musgrove Pet.

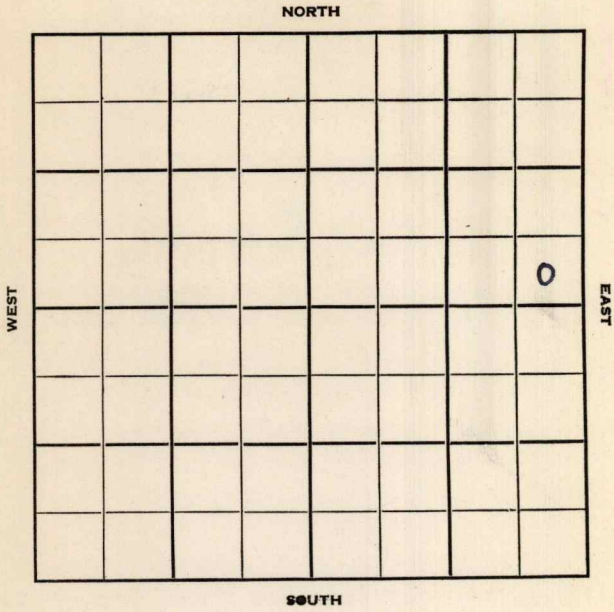

FORM 252-B
10M 8-51 TPCO.

Rice

KANSAS ✓

Sec. 35 Twp. 19 R. 6W

Well No. #1 Smyers Farm

Musgrove Company

Musgrove Pet. Contractor

Smyers


Ft. from N. Line

330 Ft. from S. Line

330 Ft. from E. Line

Ft. from W. Line

SE SE NE

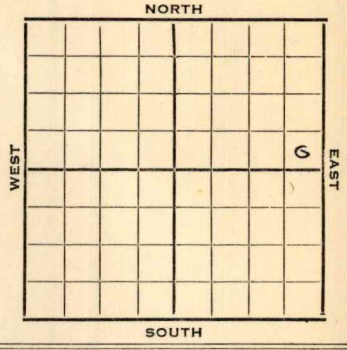


| 1952 | Elev. 1552' REPORT |
|---|---|
| 6/18 | Spud 6-14-52<br>8" @ 175'<br>Anhy 800'<br>Drlg. 968' |
| 6/25 | Drlg. 3210' |
| 7/2 | Lans. 2737 Miss 3261<br>RTD 3265 5" @ 3263<br>DP DD 3269 SSO DD 3273 SSO DD |
| 7/9 | DD 3276' B/6 BO 6 hrs. PB 3220'<br>24/3214-18 Hyd |
| 7/17 | NR |
| 7/23 | P. 50 Bopd & 30% wtr. |
| 7/30 | NR |
| 8/6 | P/4 Boph & 30% wtr. |
| 8/13 | Spud 6-14-52<br>oil Well TD 3276 8" @ 175'<br>Anhy 800 Lans. 2737<br>Miss. 3261<br>TD 3265' 5" @ 3263 DD 3269<br>SSO DD 3273 SSO DD 3276<br>B/ 6 bo 6 hr. PB 3220<br>24/ 3214-18 Hydro P/ 50 bopd<br>30% wtr. P/ 4 boph 30% wtr.<br>Comp. 21 bopd 9 bw |

COMPLETED

FORM 275 FOR SALE BY KANSAS BLUE PRINT CO.


County Rice State Kansas

Sec. 35 (Blk. Twp.) 19 (Sur. Rge.) 6W Map No.

Operator Musgrove Pet.

Well No. 1 Farm Smyers

Elev. Location SE SE NE

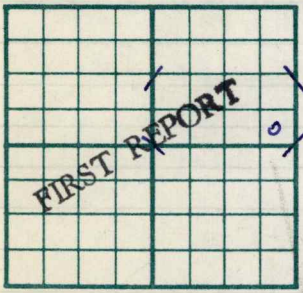


330 Ft. From S Line NE

330 Ft. From E Line Quarter

1st. Report JUN 18 1952

Completion

Remarks

Musgrove Pet. - Contr.

Spudding Date 6-14-52

Drlg. Data Smyers

8" @ 175 Anhy 800 Drlg. 968

J. G. McGEHEE

FORM 275 FOR SALE BY KANSAS BLUE PRINT CO.


County Rice State Kansas

Sec. 35 (Blk. Twp.) 19 (Sur. Rge.) 6W Map No.

Operator Musgrove Pet.

Well No. 1 Farm Smyers

Elev. 1552 Location SE SE NE

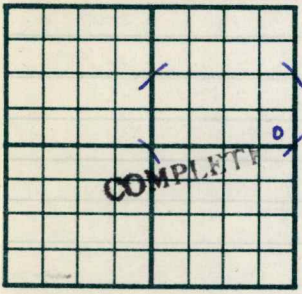


330 Ft. From S Line NE

330 Ft. From E Line Quarter

1st. Report

Completion AUG 13 1952

Remarks

Musgrove Pet. - Contr.

Spudding Date 6-14-52

Drlg. Data Oil well TD 3276

8" @ 175 Anhy 800 Lans. 2787 Miss.

3261 TD 3265 5" @ 3263 DD 3269

SSo DD 3273 SSO DD 3276 B/ 6 bo

6 hr. PB 3220 24/ 3214-18 Hydro.

P/ 50 bopd 30% water P/ 4 boph 30% w

Comp. 21 bopd 9 bw

J. G. McGEHEE