KANSAS


FORM 51 5M 10-41 PETROL

Rice

Section 36 Township 19 Range 6-W

Well No. #1 Carlson

Company Continental

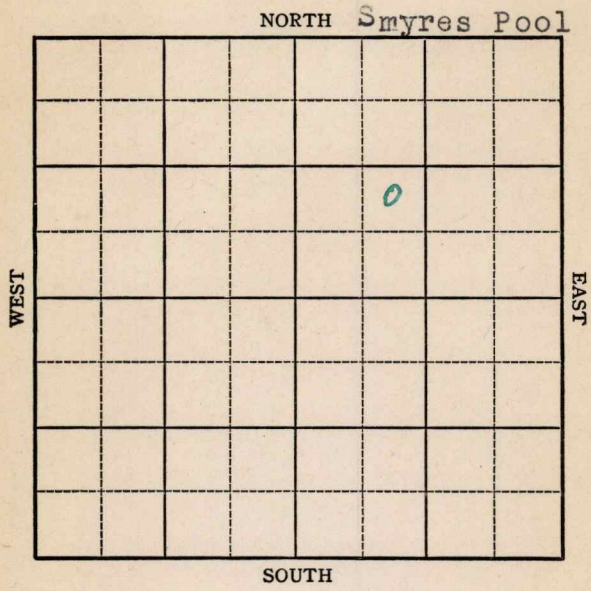

FORM 252-A
5M 10-41 PETROL

KANSAS Rice

Sec. 36 Twp. 19 R. 6-W

Well No. #1 Carlson Farm

Continental Company


(Smyres)

_____ Ft. from N. Line

990 Ft. from S. Line

_____ Ft. from E. Line

990 Ft. from W. Line

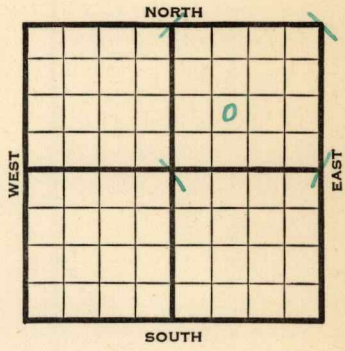

Elev. 1605

1942	REPORT
5/13	Location
5/20	10" - 162' Drlg. 750'
5/27	Drlg. 2786'
6/3	Miss. 3356-62' T.D. 6" - 3362' RUST.
6/14	T.D. 3404' 2000' oil.
6/17	" " "
6/24	Shot 30 qts. 3385-3400' 3000' oil.
7/1	Drlg. 3360' 3000' oil.
7/8	T.D. 3404' C.O.
7/15	Miss. 3356'
	6" - 3362'
	T.D. 3404'
	Shot 30 qts. 3385-3400'
	Potential 509 bbls., pump.
	37. Gravity
	COMPLETED

Form 26 200 Bks. 5-41 McW. Rice KANSAS

Map No. 48 Sec. 36 Twp. 19 R. 6W


Well No. 1 Carlson

Continental Company

FIRST REPORT Contractor

NE SW NE

SECTION PLAT

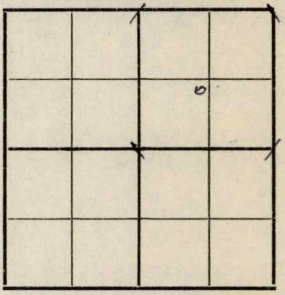

____ Ft. from N. Line

990 Ft. from S. Line

____ Ft. from E. Line

990 Ft. from W. Line

SMYRES POOL

Location XX

Rig up

Drilling and Remarks:

RECORD

Cased ____ in., ____ ft.

Sand

Gas

Oil

Total Depth

PRODUCTION

1st 24 hrs. Nat.

1st 24 hrs. after shot

Gas ____ Cu. Ft.

Dry Hole

Abandoned

Date

MAY 13 1942 19 S. J. LEWIS Scout

Form 26 200 Bks. 5-41 McW.

Rice

KANSAS

Map No. 48 Sec. 36 Twp. 19 R. 6W

Well No. 1 Carlson

Continental Company

COMPLETED Contractor

NE SW NE


Ft. from N. Line

990 Ft. from S. Line

Ft. from E. Line

990 Ft. from W. Line

SECTION PLAT

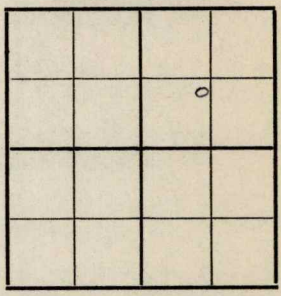

SMYRES POOL

Location

Rig up

Drilling and Remarks:

Rec'd 3356
6" @ 3362
309 ft. 3383-3400
Pump 509 BF
87% Gr

RECORD

Cased in., ft.

Sand

Gas

Oil

Total Depth 3407

PRODUCTION

1st 24 hrs. Nat.

1st 24 hrs. after shot

Gas Cu. Ft.

Dry Hole

Abandoned

Date

JUL 15 1942 19

S. J. LEWIS Scout