KANSAS Rice


FORM 51 5M 4-41 PETROL

Section 36 Township 19 Range 6-W

Well No. #2 Carlson

Company Continental

Smyres Pool

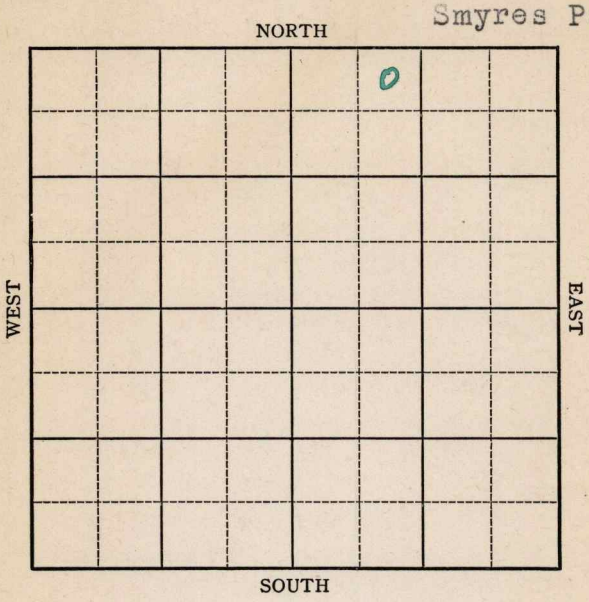

FORM 252-A
5M 10-41 PETROL

KANSAS

Rice

Sec. 36 Twp. 19 R. 6-W

Well No. #2 Carlson Farm

Continental Company

(Smyres)


330 Ft. from N. Line

_____ Ft. from S. Line

_____ Ft. from E. Line

990 Ft. from W. Line

Elev. 1598

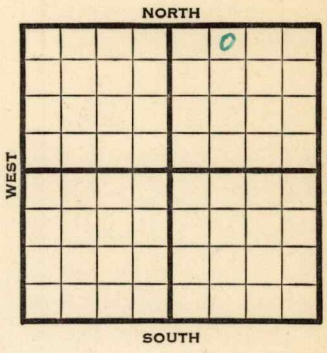

1942	REPORT
6/10	10" - 160'
	Drlg. 1190'
6/17	Drlg. 2470'
6/24	Miss. 3354-58' T.D. 6" - 3356' WOC.
7/1	Drlg. 3391' 3100' oil.
7/8	T.D. 3421' C.O.
7/15	Miss. 3354'
	6" - 3356'
	T.D. 3421'
	P.B. to 3406'
	Potential 468 bbls., pump.
	37. Gravity
	COMPLETED

Form 26 200 Bks. 5-41 McW.

Rice

KANSAS

Map No. 48 Sec. 36 Twp. 19 R. 6W

Well No. 2 Carlson

Continental Company

FIRST REPORT Contractor

NE NW NE


330 Ft. from N. Line

____ Ft. from S. Line

____ Ft. from E. Line

990 Ft. from W. Line

SECTION PLAT

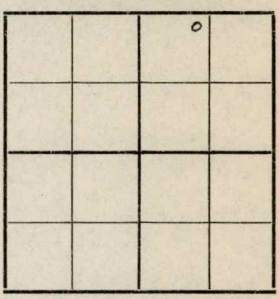

SMYRES POOL

Location

Rig up

Drilling and Remarks:

10" - 160'

Drlg. 1190'

RECORD

Cased ____ in., ____ ft.

Sand

Gas

Oil

Total Depth

PRODUCTION

1st 24 hrs. Nat.

1st 24 hrs. after shot

Gas ____ Cu. Ft.

Dry Hole

Abandoned

Date

JUN 1 0 1942 19

S. J. LEWIS Scout

Form 26 200 Bks. 5-41 McW. Rice KANSAS

Map No. 48 Sec. 36 Twp. 19 R. 6W

Well No. 2 Carlson

Continental Company

COMPLETED Contractor

NE NW NE


330 Ft. from N. Line

Ft. from S. Line

Ft. from E. Line

990 Ft. from W. Line

SECTION PLAT

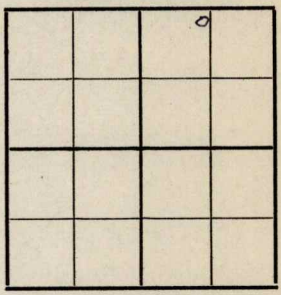

SMYERS POOL

Location

Rig up

Drilling and Remarks:

Miss 3354
6" @ 3356
PB 3406
Pump 468 BO
37° Gr

RECORD

Cased in., ft.

Sand

Gas

Oil

Total Depth 8421

PRODUCTION

1st 24 hrs. Nat.

1st 24 hrs. after shot

Gas Cu. Ft.

Dry Hole

Abandoned

Date

JUL 15 1942 19

S. J. LEWIS Scout