


Section 36 Township 19 Range 6-W

Well No. #3 A. F. Carlson

Company Continental Oil

Smyres Pool

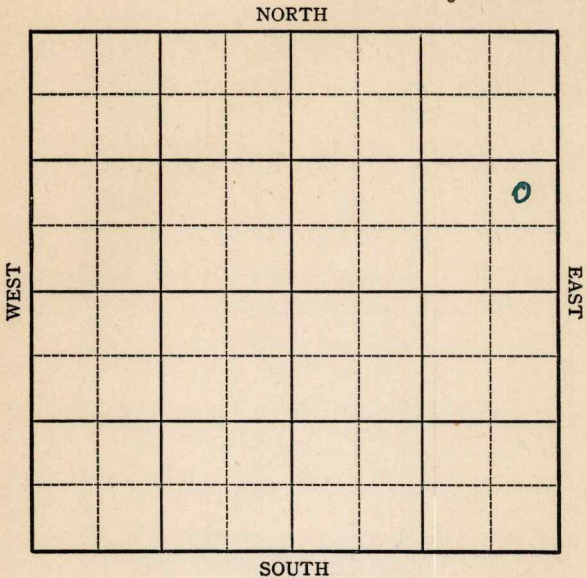

Sec. 36 Twp. 19 R. 6-WWell No. #3 A. F. Carlson FarmContinental Oil Company


(Smyres)

Ft. from N. Line

990 Ft. from S. Line330 Ft. from E. Line

Ft. from W. Line

Elev. 1610

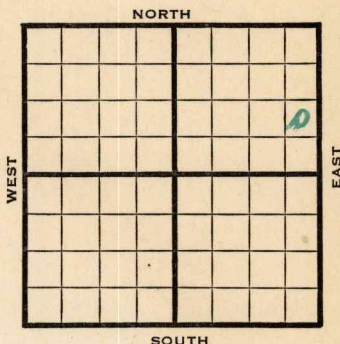

1942

## REPORT

7/1 Surface hole.  
7/8 10" - 164' Drlg. 2078'  
7/15 Drlg. 3377'  
7/22 Miss. 3417 6" @ 3419'  
Drlg. 3442-1400' oil 4½ hrs.  
7/29 T.D. 3452, 3000 oil  
40 qts. 3434-47 swb 110 oil in 6 hrs.  
8/5 Miss. 3417' 6" - 3419'  
T.D. 3452'  
Pump 403 oil & 11 water Pot.  
Gravity 37.

COMPLETED

Map No. 48 Sec. 36 Twp. 19 R. 6WWell No. 3 A. F. CarlsonContinental Oil Company**FIRST REPORT** Contractor

NE SE NE

## SECTION PLAT

|  |  |  |   |
|--|--|--|---|
|  |  |  |   |
|  |  |  | o |
|  |  |  |   |
|  |  |  |   |

       Ft. from N. Line990 Ft. from S. Line330 Ft. from E. Line       Ft. from W. Line

SMYRES POOL

Location                                 Rig up                                 

Drilling and Remarks:

Surface Hole

## RECORD

Cased            in.,            ft.Sand                                 Gas                                 Oil                                 Total Depth                                 

## PRODUCTION

1st 24 hrs. Nat.                                 1st 24 hrs. after shot                                 Gas                                  Cu. Ft.Dry Hole                                 Abandoned                                 

Date

JUL 1 1942

S. J. LEWIS

Scout

KANSAS

Rice

Map No. 48 Sec. 36 Twp. 19 R. 6WWell No. 3 A. F. CarlsonContinental Oil CompanyCOMPLETEL Contractor

NE SE NE

## SECTION PLAT

|  |  |  |  |
|--|--|--|--|
|  |  |  |  |
|  |  |  |  |
|  |  |  |  |
|  |  |  |  |

Ft. from N. Line

990 Ft. from S. Line330 Ft. from E. Line

Ft. from W. Line

SMYRES POOL

Location \_\_\_\_\_

Rig up \_\_\_\_\_

Drilling and Remarks:

Miss 34176" @ 3418Prod. 409 oil  
+ 11 Water Prod37 @ 34

## RECORD

Cased \_\_\_\_\_ in., \_\_\_\_\_ ft.

Sand \_\_\_\_\_

Gas \_\_\_\_\_

Oil \_\_\_\_\_

Total Depth 3452

## PRODUCTION

1st 24 hrs. Nat. \_\_\_\_\_

1st 24 hrs. after shot \_\_\_\_\_

Gas \_\_\_\_\_ Cu. Ft.

Dry Hole \_\_\_\_\_

Abandoned \_\_\_\_\_

Date

AUG 5 1942 19S. J. LEWIS Scout