

KANSAS


FORM 51 5M 10-41 PETROL

Rice

Section 36 Township 19 Range 6-W

Well No. #1 Hill

Company Transwestern

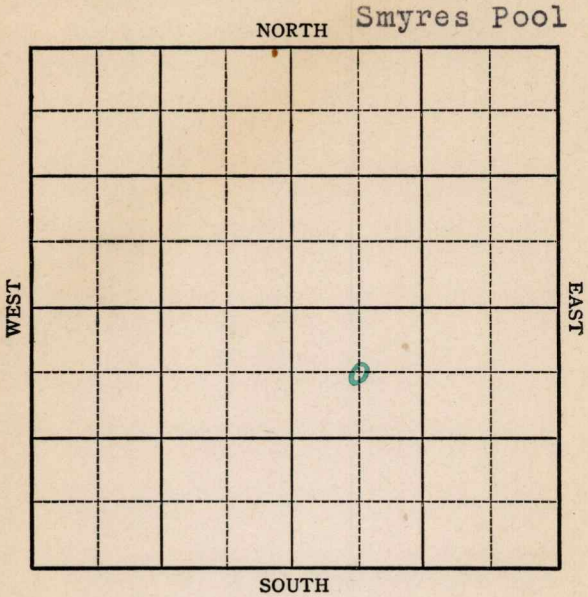

KANSAS

Rice

Sec. 36 Twp. 19 R. 6-W

Well No. #1 Hill Farm

Transwestern Company


(Smyres)

660 Ft. from N. Line

Ft. from S. Line

Ft. from E. Line

660 Ft. from W. Line

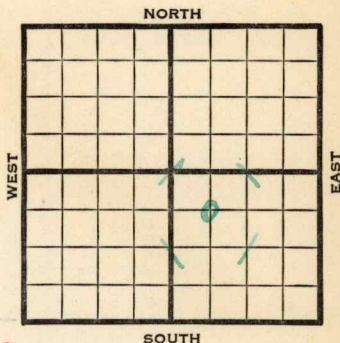

Elev. ~~1584~~ 1596

	REPORT
1942	
4/15	Location
4/22	"
4/29	"
5/6	"
5/13	Rotary.
5/20	8" - 145' Drlg. 2470'
5/27	Lans. 2771' Miss. 3351-54' T.D.
	5" - 3353' RUST.
6/3	T.D. 3372' H.F.O. in 8 hours.
6/10	Miss. 3351'
	5" - 3353'
	T.D. 3372'
	Potential 467 bbls., pump.
	37. Gravity
	COMPLETED


Rice

KANSAS

Map No. 48 Sec. 36 Twp. 19 R. 6WWell No. 1 HillTranswestern CompanyFIRST REPORT Contractor

C NW SE

SECTION PLAT

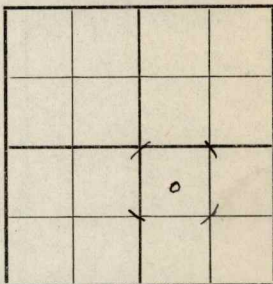660 Ft. from N. Line Ft. from S. Line Ft. from E. Line660 Ft. from W. Line

SMYRES POOL

Location XXRig up

Drilling and Remarks:

RECORD

Cased in., ft.Sand Gas Oil Total Depth

PRODUCTION

1st 24 hrs. Nat. 1st 24 hrs. after shot Gas Cu. Ft.Dry Hole Abandoned

Date

APR 15 1942

19

S. J. LEWIS

Scout

Rice

KANSAS

Map No. 48 Sec. 36 Twp. 19 R. 6WWell No. 1 Hill

Transwestern

Company

COMPLETED

Contractor

C NW SE

SECTION PLAT

660 Ft. from N. Line

Ft. from S. Line

Ft. from E. Line

660 Ft. from W. Line

SMYRES POOL

Location

Rig up

Drilling and Remarks:

*W/line 3357**8" 03353**Pump 46728**370 Gr*

RECORD

Cased _____ in., _____ ft.

Sand _____

Gas _____

Oil _____

Total Depth 3372

PRODUCTION

1st 24 hrs. Nat. _____

1st 24 hrs. after shot _____

Gas _____ Cu. Ft.

Dry Hole _____

Abandoned _____

Date

JUN 10 1942 19

S. J. LEWIS

Scout