


Rice county

Section 36 Township 19 Range 6-WWell No. #1, HillCompany Westgate-Greenland

KANSAS

Rice

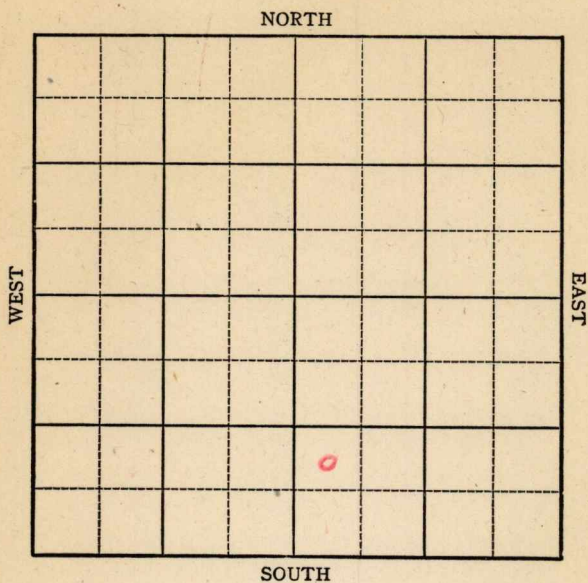

Sec. 36 Twp. 19 R. 6W

Well No. #1 Hill Farm

Westgate-Greenland Company


Bornholdt

Ft. from N. Line

990 Ft. from S. Line

Ft. from E. Line

330 Ft. from W. Line

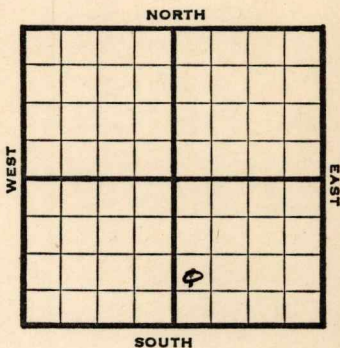

NW SW SE

1946

REPORT

Elev. 1594'

10/23

Chat 3341'

7" @ 3341'

TD 3343'

10/29

TD 3365'

1000' oil plus 500' W in 16 hrs

11/6

Chat 3341'

7" @ 3341'

Pump 528 oil plus 16% W Pot

Grav. 39

TD 3365'

COMPLETED

Kansas

Map No. 4/8 Sec. 36 Twp. 19 R. 6WWell No. 1 HillWestgate-Greenland Company**FIRST REPORT** Contractor

NW SW SE

SECTION PLAT

		0	

 Ft. from N. Line990. Ft. from S. Line Ft. from E. Line330 Ft. from W. LineRice CountyLocation Rig up

Drilling and Remarks:

Chat 3341

7" @ 3341

TD 3343

RECORDCased in., ft.Sand Gas Oil Total Depth **PRODUCTION**1st 24 hrs. Nat. 1st 24 hrs. after shot Gas Cu. Ft.Dry Hole Abandoned

Date

OCT 23 1946 19S. J. LEWIS Scout

Map No. 48 Sec. 36 Twp. 19 R. 6W

Well No. 1 Hill

Westgate-Greenland Company

COMPLETED

Contractor

NW SW SE


61,1594
SECTION PLAT

 Ft. from N. Line

990 Ft. from S. Line

 Ft. from E. Line

330 Ft. from W. Line

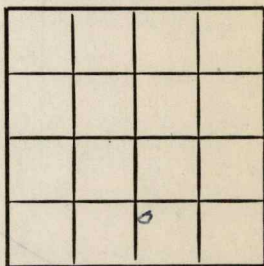

Rice County

Location

Rig up

Drilling and Remarks:

Chas 3341

7" 3341

Pump 525 oil +

16% H₂O

3341

RECORD

Cased in., ft.

Sand

Gas

Oil

Total Depth 3865

PRODUCTION

1st 24 hrs. Nat.

1st 24 hrs. after shot

Gas Cu. Ft.

Dry Hole

Abandoned

Date

NOV 6 1946

19

S. J. LEWIS

Scout