

KANSAS


Rice

FORM 51 5M 10-41 PETROL

Section 36 Township 19 Range 6-W

Well No. #2 Hill

Company W. C. McBride Inc.

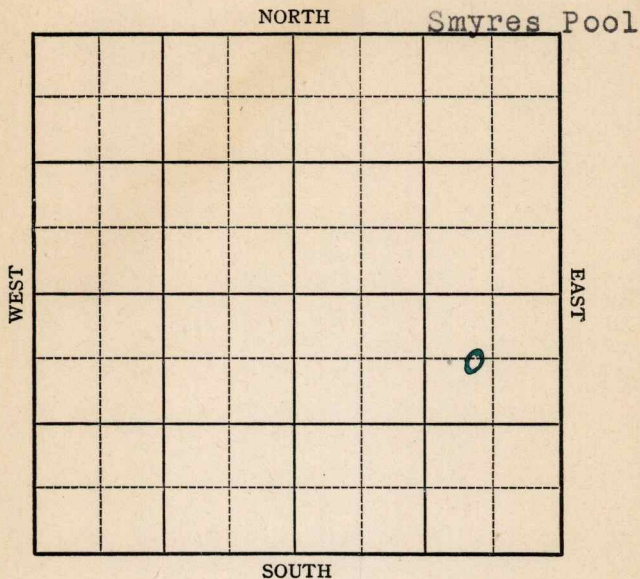

Sec. 36 Twp. 19 R. 6-W

Well No. #2 Hill Farm

W. C. McBride, Inc. Company

(Smyres)


660 Ft. from N. Line

 Ft. from S. Line

800 Ft. from E. Line

 Ft. from W. Line

Elev. 1593

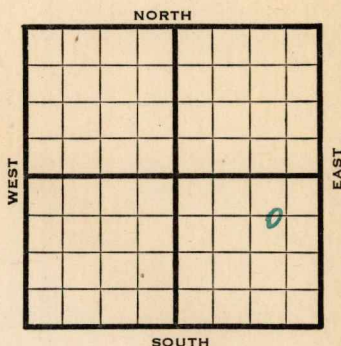

1942

REPORT

7/1 8" - 144'
Drlg. 2152'

7/8 Miss. 3398' Drlg. 3402'

7/15 T.D. 3434' 2000' oil & 150' water.

7/22 5" @ 3397'
Miss. 3396½'
T.D. 3434'
Pump 232 Pot.
Gravity 37

COMPLETED

Map No. 48 Sec. 36 Twp. 19 R. 6WWell No. 2 HillW. C. McBride Inc. Company

FIRST REPORT

Contractor

Approx.

C NE SE

660 Ft. from N. Line Ft. from S. Line800 Ft. from E. Line Ft. from W. Line

SECTION PLAT

			o

SMYRES POOL

Location Rig up

Drilling and Remarks:

8" - 144'

Dr1g. 2152'

RECORD

Cased in., ft.Sand Gas Oil Total Depth

PRODUCTION

1st 24 hrs. Nat. 1st 24 hrs. after shot Gas Cu. Ft.Dry Hole Abandoned

Date

JUL 1 1942 19S. J. LEWIS Scout

Rice

KANSAS

Map No. 78 Sec. 36 Twp. 19 R. 6WWell No. 2 HillW. C. McBride Inc. CompanyCOMPLETED Contractor

Approx. C NE SE

SECTION PLAT

660 Ft. from N. Line Ft. from S. Line800 Ft. from E. Line Ft. from W. Line

			0

SMYRES POOL

RECORD

Location Cased in., ft.Rig up Sand

Drilling and Remarks:

Gas Oil Total Depth 3434

PRODUCTION

1st 24 hrs. Nat. 1st 24 hrs. after shot Gas Cu. Ft.Dry Hole Abandoned

Date

JUL 22 1942 19S. J. LEWIS Scout*Miss 8396 1/2**5" @ 3397**Pump 232 Pst**37 @ 34*