

KANSAS


FORM 51 5M 10-41 PETROL

Rice

Section 25 Township 19 Range 6-W

Well No. #1 Anderson

Company R. S. Shade et al

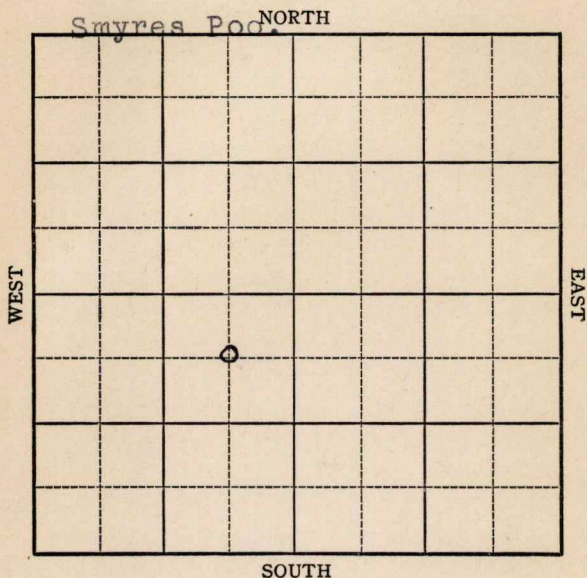

KANSAS

Rice

Sec. 25 Twp. 19 R. 6-W

Well No. #1 Anderson Farm

R. S. Shade et al Company

(Smyres Pool)


660 Ft. from N. Line

Ft. from S. Line

515 Ft. from E. Line

Ft. from W. Line

Elev. 1604

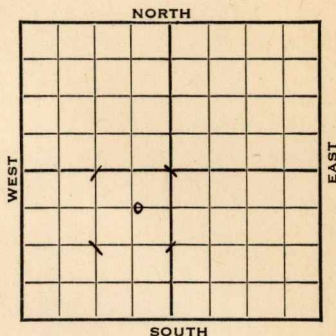

1942

REPORT

7/29

Location

8/5

8" - 182 WOC

8/12

2403 fsg.

8/19

Miss. 3370

T.D. 3374

5" - 3373

RUST.

8/27

TD 3387 HFO

9/2

T.D. 3396

3250' oil

9/9

Miss. 3370

5" - 3373

T.D. 3396

Echo Pot. 4302

Max. 3000

Gravity 37.

COMPLETED

KANSAS

Rice


Map No. 48 Sec. 25 Twp. 19 R. 6WWell No. 1 AndersonR. S. Shade etal. Company

FIRST REPORT

Contractor

C NE SW

SECTION PLAT

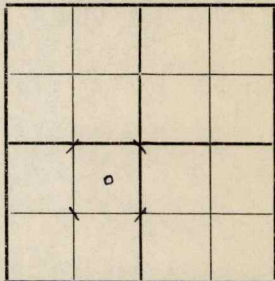660 Ft. from N. Line

Ft. from S. Line

515 Ft. from E. Line

Ft. from W. Line

SMYRES POOL

Location XXX

Rig up

Drilling and Remarks:

RECORD

Cased _____ in., _____ ft.

Sand _____

Gas _____

Oil _____

Total Depth _____

PRODUCTION

1st 24 hrs. Nat. _____

1st 24 hrs. after shot _____

Gas _____ Cu. Ft.

Dry Hole _____

Abandoned _____

Date

JUL 29 1942

19

S. J. LEWIS

Scout

Rice

KANSAS

Map No. 48 Sec. 25 Twp. 19 R. 6WWell No. 1 AndersonR. S. Shade et al. CompanyCOMPLETED Contractor

C NE SW

660 Ft. from N. Line Ft. from S. Line515 Ft. from E. Line Ft. from W. Line

SECTION PLAT

	o		

SMYRES POOL

Location Rig up

Drilling and Remarks:

Miss 33705" @ 3373Eclw P 4802Max 300037° Gr

RECORD

Cased in., ft.Sand Gas Oil Total Depth 3396

PRODUCTION

1st 24 hrs. Nat. 1st 24 hrs. after shot Gas Cu. Ft.Dry Hole Abandoned

Date

SEP 9 1942 19S. J. LEWIS Scout