


Section 25 Township 19 Range 6-W

Well No. #1 Mattson

Company Shade et al
~~R. S. Sledd et al~~

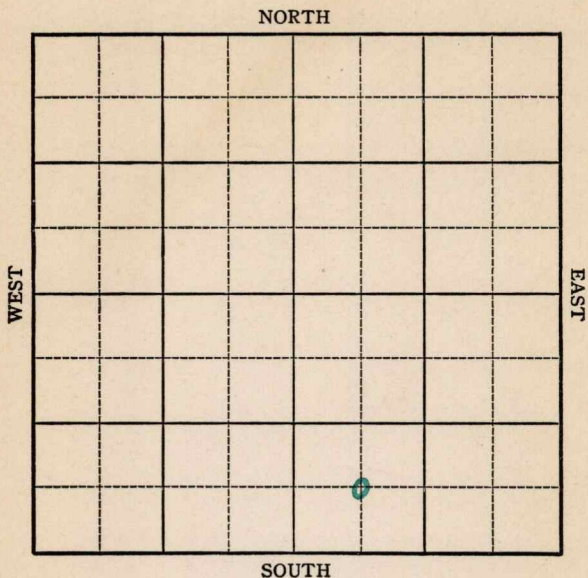


KANSAS

Rice

Map No. 48 Sec. 25 Twp. 19 R. 6WWell No. 1 MattsonR. S. Sledd et al. CompanyFIRST REPORT Contractor

C SW SE

SECTION PLAT

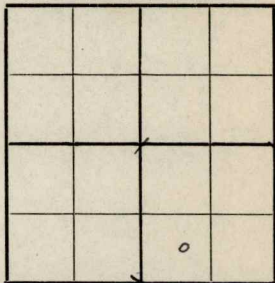 Ft. from N. Line660 Ft. from S. Line Ft. from E. Line660 Ft. from W. LineBORNHOLDT POOLLocation Rig up

Drilling and Remarks:

8" - 181'

Drlg. 610'

RECORD

Cased in., ft.Sand Gas Oil Total Depth

PRODUCTION

1st 24 hrs. Nat. 1st 24 hrs. after shot Gas Cu. Ft.Dry Hole Abandoned

Date

MAY 6 1942 19S. J. LEWIS Scout


Map No. 78 Sec. 25 Twp. 19 R. 6WWell No. 1 MattsonShade et al. Company

CORRECTION

Contractor

C SW SE

SECTION PLAT

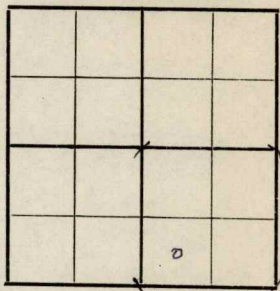

_____ Ft. from N. Line

660 Ft. from S. Line

_____ Ft. from E. Line

660 Ft. from W. Line

BORNHOLDT POOL

Location _____

Rig up _____

Drilling and Remarks:

Reported as

R. S. Sledd et al.

RECORD

Cased _____ in., _____ ft.

Sand _____

Gas _____

Oil _____

Total Depth _____

PRODUCTION

1st 24 hrs. Nat. _____

1st 24 hrs. after shot _____

Gas _____ Cu. Ft.

Dry Hole _____

Abandoned _____

Date

JUN 3 1942

19

S. J. LEWIS Scout

Rice

KANSAS

Map No. 48 Sec. 25 Twp. 19 R. 6WWell No. 1 Mattson

Shade et al.

Company

COMPLETED

Contractor

SECTION PLAT

C SW SE

Ft. from N. Line

660 Ft. from S. Line

Ft. from E. Line

660 Ft. from W. Line

BORNHOLDT POOL

Location

Rig up

Drilling and Remarks:

*Miss 3356**5" @ 3356**Pump 260 Bx.**370 yd*

RECORD

Cased _____ in., _____ ft.

Sand _____

Gas _____

Oil _____

Total Depth 3381

PRODUCTION

1st 24 hrs. Nat. _____

1st 24 hrs. after shot _____

Gas _____ Cu. Ft.

Dry Hole _____

Abandoned _____

Date

JUN 3 1942

19

S. J. LEWIS

Scout