

KANSAS

FORM 51 5M 10-41 PETROL


Rice

Section 25 Township 19 Range 6-W

Well No. #1 Mattson

Company Texas

Smyres Pool

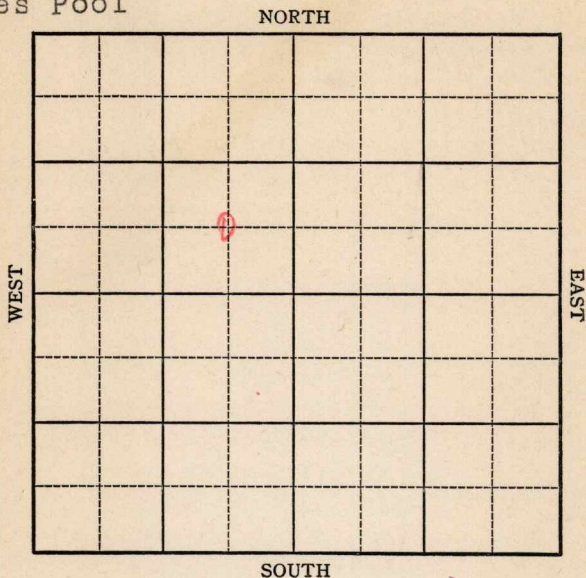

Sec. 25 Twp. 19 R. 6-W

Well No. #1 Doweess Mattison Farm

Texas

Company

(Smyres Pool)


Ft. from N. Line

660 Ft. from S. Line

660 Ft. from E. Line

Ft. from W. Line

Elw. 1579

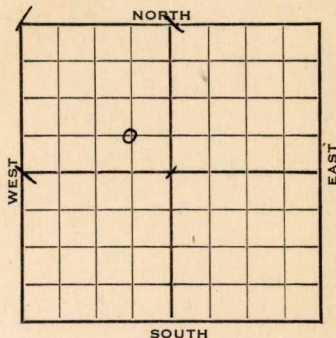

1942

REPORT

9/16

Rotary

9/23

10" @ 140 Drlg 2025

9/30

Drlg. 3225

10/7

Miss. 3362 5" - 3390

TD 3398 RUST

10/14

Ripped cag. 3362-84 swb 75 fluid
 $\frac{1}{4}$ water in 6 hrs.

10/21

pump 56 oil & 10% water in 6 hrs.

10/28

" " " " "

11/4

" " " " "

11/11

" " " " "

11/18

" " " " "

11/24

Chab 3362

5" @ 3390'

T.D. 3398'

Rip casing 3362-84

500 Acid

Pump 60 oil plus 7 bbls. water Pot.

Gravity 37

COMPLETED

Rice

KANSAS

Map No. 48 Sec. 25 Twp. 19 R. 6WWell No. 1 Mattson

Texas

Company

CORRECTION

Contractor

C SE SW

SECTION PLAT

	o		

_____ Ft. from N. Line

660 Ft. from S. Line660 Ft. from E. Line

_____ Ft. from W. Line

SMYRES POOL

Location _____

Rig up _____

Drilling and Remarks:

Reported

#1 Dewees

RECORD

Cased _____ in., _____ ft.

Sand _____

Gas _____

Oil _____

Total Depth _____

PRODUCTION

1st 24 hrs. Nat. _____

1st 24 hrs. after shot _____

Gas _____ Cu. Ft.

Dry Hole _____

Abandoned _____

Date

9/191942

S. J. LEWIS

Scout

Rice

KANSAS

Map No. 48 Sec. 25 Twp. 19 R. 6WWell No. 1 Dewees

Texas


Company

FIRST REPORT

Contractor

C S E NW

SECTION PLAT

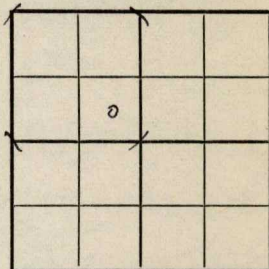

Ft. from N. Line

660

Ft. from S. Line

660

Ft. from E. Line

Ft. from W. Line

SMYRES POOL

Location

Rig up

Drilling and Remarks:

Rotary

RECORD

Cased _____ in., _____ ft.

Sand _____

Gas _____

Oil _____

Total Depth _____

PRODUCTION

1st 24 hrs. Nat. _____

1st 24 hrs. after shot _____

Gas _____

Cu. Ft.

Dry Hole _____

Abandoned _____

Date

SEP 16 1942 19

S. J. LEWIS

Scout

KANSASMap No. 48 Sec. 25 Twp. 19 R. 6WWell No. 1 MattsonTexas

Company

COMPLETED

Contractor

C SE NW

SECTION PLAT

	6		

 Ft. from N. Line660 Ft. from S. Line660 Ft. from E. Line Ft. from W. Line

SMYRES POOL

Location Rig up

Drilling and Remarks:

*Ok 83362**5" 3390**Rip csg. 3362-84**500 acid**Pump. 60 oil +**7 Water P & F**379 Gr*

Date

RECORD

Cased in., ft.Sand Gas Oil Total Depth 3398

PRODUCTION

1st 24 hrs. Nat. 1st 24 hrs. after shot Gas Cu. Ft.Dry Hole Abandoned

NOV 24 1942 19

S. J. LEWIS

Scout