


Section 25 Township 19 Range 6W

Well No. #1 Mattson

Company Lance Hill et al

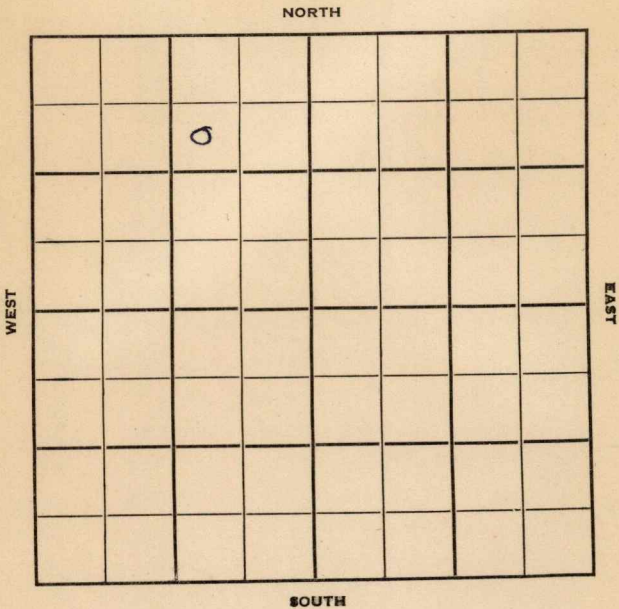

Rice

KANSAS ✓

Sec. 25 Twp. 19 R. 6W

Well No. #1 Mattson Farm

Lance Hill et al Company

Braden Drlg. Contractor

990 Ft. from N. Line


Ft. from S. Line

990 Ft. from E. Line

Ft. from W. Line

SW NE NW

Texas FO

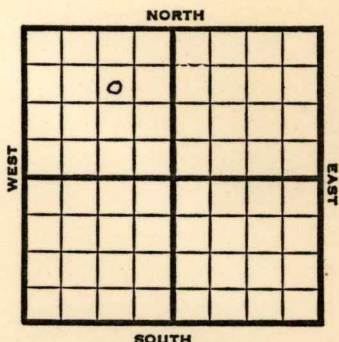

1952

Elev. 1587'

REPORT

10/8

Spud 10-1-52
8" @ 156'
Drlg. 2950'

10/15

Lans 2789, Cong 3336, Miss 3355
RTD 3371,
5" @ 3368'

10/22

DD 3390' TD Set packer @ 3330' Hyd
fill up 2070' oil S/10 BOPH
BOP

10/29

- Spud 10-1-52
Oil Well
TD 3390'
8" @ 156
Lans 2789, Cong. 3336, Miss 3355
TD 3371',
5" @ 3368
DD 3390, SP 3330, Hydro. FU 2070'
oil S/10 boph
Comp. 40 bopd

COMPLETED

County Rice State KansasSec. 25 (Blk.
Twp.) 19 (Sur.
Rge.) 6W Map No.Operator Lance Hill et al.Well No. 1 Farm MattsonElev. 1587 Location SW NE NW990 Ft. From N Line NW990 Ft. From E Line Quarter1st. ReportCompletion OCT 29 1952RemarksBraden Drlg. - Contr.Spudding Date 10-1-52Drlg. Data Oil well TD 33908" @ 156 Lans. 2789 Cong. 3336Miss. 3355 TD 3371 5" @ 3368DD 3390 SP 3330 Hydro. FU 2070'oil S/ 10 boph Comp. 40 bopd

J. G. McGEHEE