

Rice


KANSAS

SECTION 25 TOWNSHIP 19 RANGE 6W

WELL NO. #2 Went (Wendt)

COMPANY Sterling Drlg.

NORTH

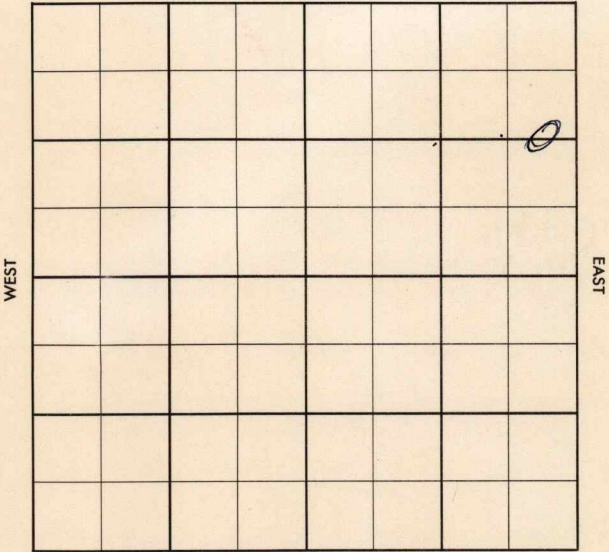

SOUTH

County Rice Elev. _____
 Sec. 25 Twp. 19 Rge. 6W
 Company Sterling Drlg.
 Farm Name Went No. 2

TOPS	DEPTH	LOG	DATUM	Loc. in Sec.
Anh.				C E $\frac{1}{2}$ E $\frac{1}{2}$ NE
Tr.				
H.				
Tr.				
Dg.				
Bl.				
L.				Geol. _____
K.C.				Contr. _____
B.K.C.				<u>Sterling Drlg.</u>
Ce.				Pool _____
C.				<u>Windom</u>
M.				
M.				
K.				
Mz.				
Me.				
V.				
S.				
S.				
A.				
R.				
Pc.				
G.				
T.D.				

JAN 3 '57

FIRST REPORT

Date Comm. _____
 Location _____

Handwritten mark

County Rice Elev. 1615
 Sec. 25 Twp. 19 Rge. 6W
 Company Sterling Drif.
 FarmName Went No. 2

TOPS	DEPTH	LOG	DATUM	Loc. in Sec.
Anh.				C E ¹ E ¹ NE
Tr.				
Dg.				
Bl.	2586			
L.	2777			
K.C.	2795			Geol.
B.K.C.				Contr.
Ce.				Sterling Drif.
C.	3385			Pool
M.	3437			Window
K.				
Mz.				
Mo.				
V.				
S.				
S.				
A.				
R.				
PE.				
G.				
TD.	3450			COMPLETE

Date Comm.

Location 1-9-57 MIR JAN 15 '57
1-9-57 878 200/175
Ø 2590 JAN 23 '57 DST 3084-95
or 45" sec 25' Md (550) BHP
Ø DST 3402-10 on 2 hrs
sec. 30' oil spkd Md BHP 20
5/2 @ 3450 JAN 30 '57 MICT 12/3404
-08 1/4 \$ 1 GFPH + TR. WTR.
ERAC \$ LD FEB 6 '57 Lost Load PB

3400 32/3386-94 F1AC 8

9 Boph no/wtr FEB 13 '57 P. 3 1/2

Boph 10 hrs no/wtr FEB 20 '57

FEB 27 '57 MAR 6 '57 MAR 13 '57 MAR 20 '57

25 Bopd no/wtr P.