


Ride.

KANSAS
FORM 51 5M 10-41 PETROL

Section 25 Township 19 Range 6-W

Well No. #1 Ester Wendt

Company Continental

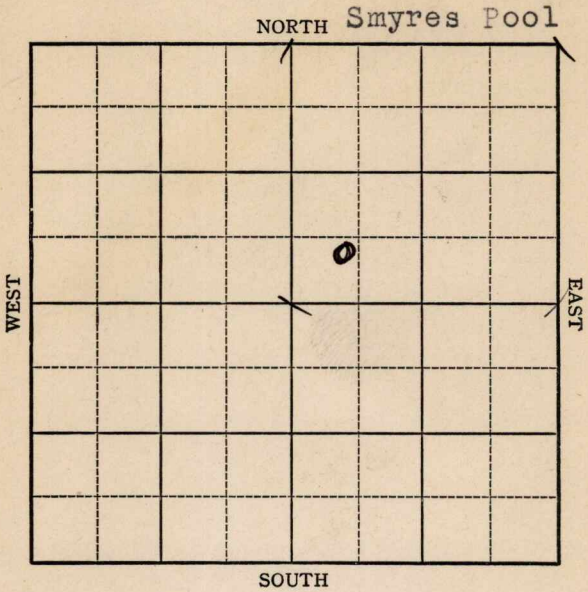

KANSAS Rice

Sec. 25 Twp. 19 R. 6-W

Well No. #1 Esther Wendt Farm
Continental Company

(Smyres Pool)

Ft. from N. Line

560


Ft. from S. Line

Ft. from E. Line

560

Ft. from W. Line

Elev. 1609

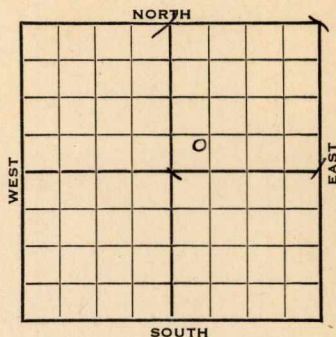

1942

REPORT

7/22	Location
7/29	Derrick
8/5	10" - 172 Drlg. 1545'
8/12	Miss 3416-19 TD 6" @ 3419 Rust
8/19	Drlg 3434 - 600' oil
8/27	TD 3454 HFO
9/2	" " "
9/9	50 qts 3428-44 swb 142 oil plus 17½ water in 4½ hrs CO.
9/16	Chat. 3416 6" - 3419 50 qts. 3428-44 Pump 428 oil & 81 water T.D. 3454 Gravity 37. COMPLETED

Rice


KANSAS

Map No. 48 Sec. 25 Twp. 19 R. 6WWell No. 1 Esther WendtContinental Company
FIRST REPORT

Contractor

C SW NE

SECTION PLAT

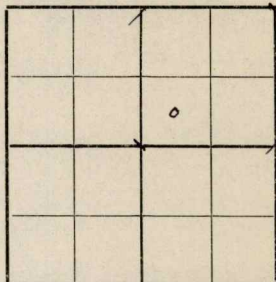

Ft. from N. Line

560 Ft. from S. Line

Ft. from E. Line

560 Ft. from W. LineSMYRES POOLLocation XXX

Rig up

Drilling and Remarks:

RECORD

Cased _____ in., _____ ft.

Sand _____

Gas _____

Oil _____

Total Depth _____

PRODUCTION

1st 24 hrs. Nat. _____

1st 24 hrs. after shot _____

Gas _____ Cu. Ft.

Dry Hole _____

Abandoned _____

Date

JUL 22 1942 19S. J. LEWIS Scout

KANSAS

Rice

Map No. 48 Sec. 25 Twp. 19 R. 6WWell No. 1 Esther WendtContinental

Company


COMPLETED

Contractor

C S W N E

 Ft. from N. Line560 Ft. from S. Line Ft. from E. Line560 Ft. from W. Line

SECTION PLAT

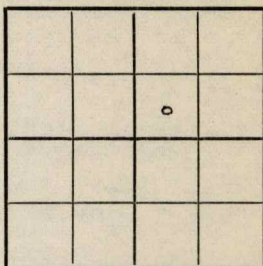

SMYRES POOL

Location Rig up

Drilling and Remarks:

*Cha 73416**6" @ 3419**509 to 3428-44**Pump 428 oil**751 Water**37-94*

RECORD

Cased in., ft.Sand Gas Oil Total Depth 3454

PRODUCTION

1st 24 hrs. Nat. 1st 24 hrs. after shot Gas Cu. Ft.Dry Hole Abandoned

Date

SEP 16 1942 19 S. J. LEWIS Scout