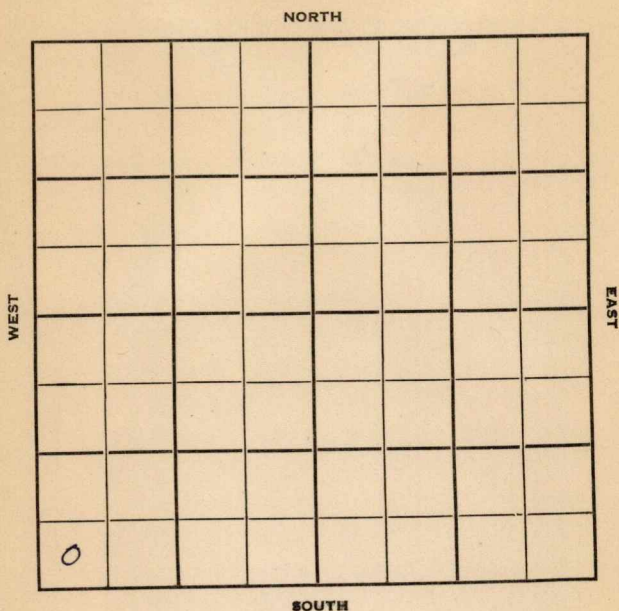


Section 30 Township 19 Range 6WWell No. #1 HardyCompany Atlantic Ref.

Rice
19

KANSAS

6W

Sec. 30 Twp. R.

Well No. #1 Hardy Farm

Atlantic Ref. Company

Lohman & Johnson Contractor

Wildcat


Ft. from N. Line

330' Ft. from S. Line

Ft. from E. Line

330' Ft. from W. Line

SW SW SW

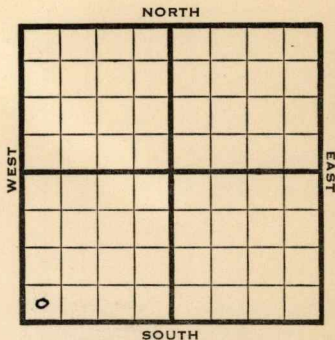

1950

Elev 1632'

REPORT

4/19

Spud 4-14-50

8-5/8" @ 236'

Drlg. 1500'

5/3

TD 3675'

8 5/8" @ 236'

Lans 2794'

Cong 3236'

Miss 3255'

Viola 3544'

Simp 3578'

Arb. 3641'

D&A

Aband.

ABANDONED

Map No. _____ Sec. 30 Twp. 19 R. 6WWell No. 1 Hardy

_____ Atlantic Ref. _____ Company

_____ Lohman & Johnson _____ Contractor

SW SW SW

SECTION PLAT

_____ Ft. from N. Line

330 Ft. from S. Line

_____ Ft. from E. Line

330 Ft. from W. Line

_____ Rice County

Location _____

Rig up _____

Drilling and Remarks:

Spud 4-14-50

8 5/8" @ 236

drlg. 1500

RECORD

Cased _____ in., _____ ft.

Sand _____

Gas _____

Oil _____

Total Depth _____

PRODUCTION

1st 24 hrs. Nat. _____

1st 24 hrs. after shot _____

Gas _____ Cu. Ft.

Dry Hole _____

Abandoned _____

Date

APR 19 1950 19

J. E. TYRA

Scout

Kansas

Wildcat

Map No. _____ Sec. 30 Twp. 19 R. 6WWell No. 1 Hardy

Atlantic Ref.

Company

Contractor

SW SW SW

E1. 1632
SECTION PLAT

_____ Ft. from N. Line

330 Ft. from S. Line

_____ Ft. from E. Line

330 Ft. from W. Line

Rice County

Location _____

Rig up _____

Drilling and Remarks:

8 5/8" @ 236
 Law 2794
 Cory 3236
 Miss 3255
 Viola 3544
 Simp 3578
 Arb 3641

Date

RECORD

Cased _____ in., _____ ft.

Sand _____

Gas _____

Oil _____

Total Depth 3675

PRODUCTION

1st 24 hrs. Nat. _____

1st 24 hrs. after shot _____

Gas _____ Cu. Ft.

Dry Hole _____

Abandoned _____

MAY 3 1950

J. E. TYRA

19

Scout