

KANSAS


Rice county

FORM 51 5M 6-46 PETROL

Section 36 Township 19 Range 6-W

Well No. #4, Carlson

Company Continental Oil Company

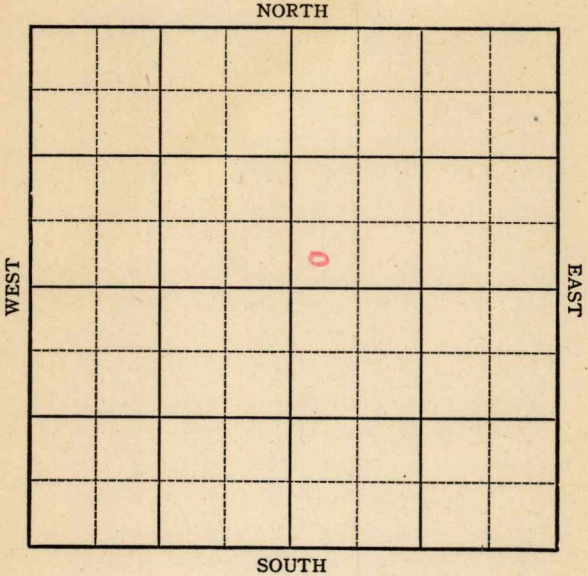

Sec. 36 Twp. 19 R. 6W

Well No. #4 Carlson Farm
Continental Company


Bernholdt Pool

Ft. from N. Line

330 Ft. from S. Line

Ft. from E. Line

330 Ft. from W. Line

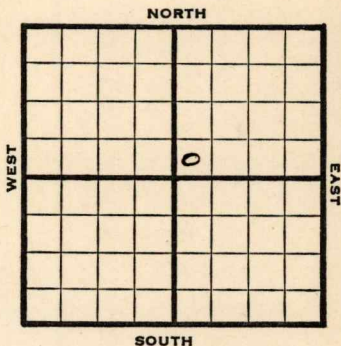

SW NE

1946 **Elev. 1601'** REPORT

- 10/23 Derrick
- 10/29 10" @ 196 WOC
- 11/6 Drlg 2674'
- 11/12 **Miss 3360'**
TD 3362'
7" @ 3359, RUST
- 11/20 TD 3388'
Swb 89 oil plus 2 W in 24 hrs
- 11/27 " " "
- 12/4 **Miss 3360'**
7" @ 3359'
TD 3388
Pump 100 POT
39 Grav.

COMPLETED

