
Rice

KANSAS

SECTION 36 TOWNSHIP 19 RANGE 6 W

WELL NO. #5 William John

COMPANY Continental

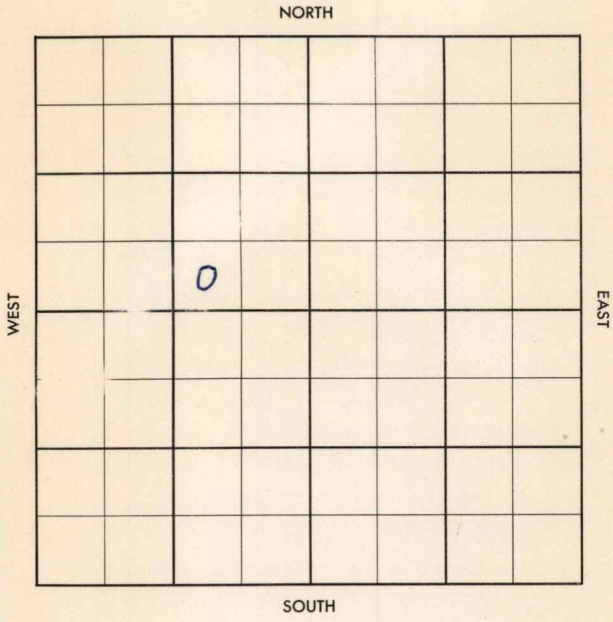

FORM 504-3 SUNRAY

Rice KANSAS

SEC.	TWP.	R.
36	19	6W

WELL NO.

#5 William John FARM

COMPANY

Continental

CONTRACTOR

Braden

Welch-Bornholdt


_____ Ft. from N. Line

_____ Ft. from S. Line

_____ Ft. from E. Line

_____ Ft. from W. Line

SW SE NW

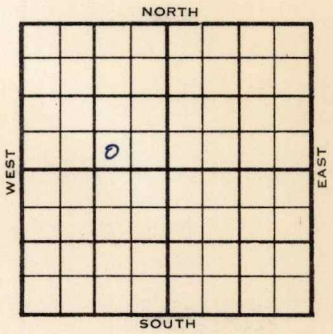

1955	ELEVATION 1587' REPORT
11/9	R U R
12-7	Comm. 11-8-55 8 5/8" @ 206/200 5½" @ 3380 CO to 3376, 84/ 3346-67 B/ 3½ gm & wph, frac S/ 7 bo 11 bw, 1 hr., PB 3338, 96/ 3305-29, frac S/ 126 bo 6 hr., CO to 3376, Comp. 108 bopd, 11 bw Tops Log. H. 2542 L. 2764 Sdy. 3250 Cg. Chert ~~3297~~ 3286 M. 3297 TD 3381'

COMPLETED

DX-78

FORM 513 REV. SUNRAY

County Rice Elev.

Sec. 36 Twp. 19 Rge. 6W

Company Continental

Farm Name William John No. 5

TOPS	DEPTH	LOG	DATUM
Anh.			
Tp.			
H.			
Tr.			
Dg.			
Bl.			
L.			
K.C.			
B.K.C.			
Ce.			
C.			
M.			
M.			
K.			
Mz.			
Mg.			
V.			
S.			
S.			
A			
R.			
P€.			
G.			
T.D.			

Loc. in Sec. SW SE NW

Geol.

Contr. Braden

Pool Welch-Bornhold

FIRST REPORT

NOV 9 '55

Date Comm.

R U R

"

Co. Lse. No. Sec. T. R.

FORM 513 REV. SUNRAY

County Rice Elev. 1587

Sec. 36 Twp. 19 Rge. 6W

Company Continental

Farm Name William John No. 5

TOPS	DEPTH	LOG	DATUM
Anh.			
Tp.			
H.		2542	955
Tr.			
Dg.			
B.L.			
L.		2764	1177
K.C.			
B.K.C.			
Ce.			
C.		3250	1663
M. Cg chert		3286	1699
M.		3297	1710
K.			
Mz.			
Mq.			
V.			
S.			
S.			
A			
R.			
P€.			
G.			
T.D.	3381		

Loc. in Sec. SW SE NW

Geol.

Contr. Braden

Pool Welch-Bornhold



Date Comm. 11-8-55

8 5/8" @ 206/200 5½" @ 3380 CO to 3376

84/ 3346-67 B/ 3½ gm & wph frac

S/ 7 bo 11 b w 1 hr. PB 3338

96/ 3305-29 frac S/ 126 bo 6 hr.

CO to 3376 Comp. 108 bopd 11 bw

Co. Lse. No. Sec. T. R.