

Rice

KANSAS

SECTION 36 TOWNSHIP 19 RANGE 6 W

WELL NO. #6 Wm. John

COMPANY Continental Oil

NORTH

0							

WEST

EAST

SOUTH

Rice

KANSAS

SEC. 36	TWP. 19	R. 6W
------------	------------	----------


WELL NO. #6 Wm. John FARM

COMPANY Continental Oil

CONTRACTOR Braden

Smyres

\_\_\_\_\_ Ft. from N. Line  
 \_\_\_\_\_ Ft. from S. Line  
 \_\_\_\_\_ Ft. from E. Line  
 \_\_\_\_\_ Ft. from W. Line

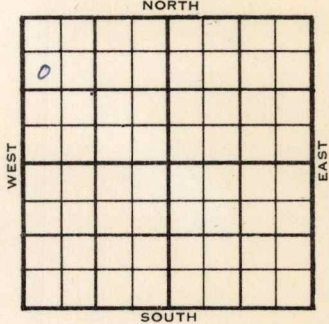

SW NW NW

1956	ELEVATION 1556 RB	REPORT
------	----------------------	--------

1-5 Comm. 12-27-55  
 8" ~~A~~ @ 196/200  
 Drlg. 3307  
 M. 3269'

2-8 P/ 40 BO / 53 BWPD  
 H. 2512  
 L. 2732  
 Sdy 3222  
 M.Chat 3269 3271  
 TD 3371

COMPLETED

1554 DF

County Reca Elev. 1556 RB  
 Sec. 36 Twp. 19 Rge. 6W  
 Company Continental Oil  
 Farm Name Wm. John No. 6

TOPS	DEPTH	LOG	DATUM	Loc. in Sec.
Am.				SW NW NW
Tp.				
H.		2512		
Tr.				
Dg.				
Bl.				
L.		2732	1178	Geol.
K.C.				
B.K.C.				Contr.
Ce.				Bradley
C. <u>Sdy</u>		3222	1668	
M. <u>chat</u>	3269	3271	1717	Pool
M.				Smyres
K.				
Mh.				
Mo.				
V.				
S.				
S.				
A.				
R.				
PC.				COMPLETE
B.				
TD	3371			

Date Comm. 12-27-55 FEB 8 1956  
 8" @ 196/200 drlg. 3307 JAN 11 '56 5 1/2 @  
 3370/200 ca 3.333 17/3304-22  
 tst 1 1/2 A M&W (spks oil) ph  
 6 hrs Frac B 1 1/2 GWM PB  
 3297 60/3229-94 20/3270-75  
 sd Frac Cu JAN 18 '56 ca 3327  
 Pop to P. Ldn JAN 25 '56 P. Ldn FEB 1 '56  
 P. 42 B0 + 53 BWpd FEB 8 '56  
 P. 40 B0 + 53 BWpd

County Rice Elev. 1556 RB  
 Sec. 36 Twp. 19 Rge. 6W  
 Company Continental Oil  
 Farm Name Wm. John No. 6

TOPS	DEPTH	LOG	DATUM
Anh.			
Tp.			
H.			
Tr.			
Dg.			
Bl.			
L.			
K.C.			
B.K.C.			
Ce.			
C.			
M.	3269		
M.			
K.			
Mz.			
Me.			
V.			
S.			
S.			
A.			
R.			
PE.			
G.			
T.D.			

Loc. in Sec. SW NW NW

Geol. \_\_\_\_\_  
 Contr. Braden

Pool Smyres

FIRST REPORT  
 JAN 5 '56

Date Comm. 12-27-55  
8" @ 196/200 drlg. 3307

12

Co. Lse. No. Sec. T. R.