KANSAS

FORM 51 5M 10-41 PETROL


Rice

Section 36 Township 19 Range 6-W

Well No. #2 Johns

Company Continental

Smyres Pool

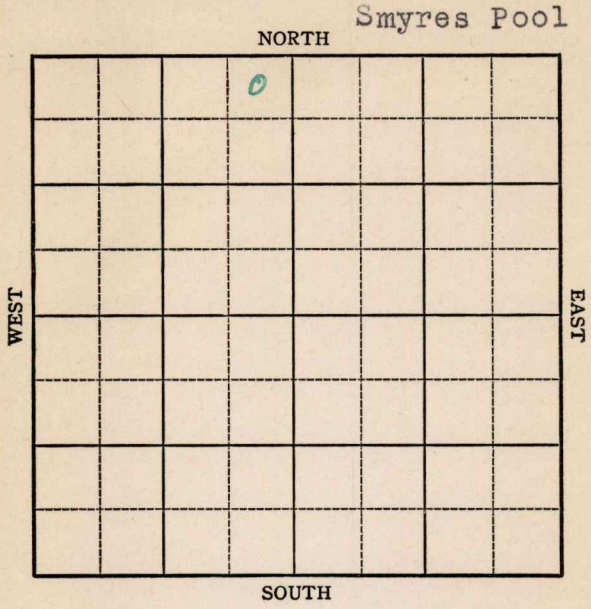

FORM 252-A
5M 10-41 PETROL

KANSAS

Rice

Sec. 36 Twp. 19 R. 6-W

Well No. #2 Johns Farm

Continental Company


(Smyres)

330 Ft. from N. Line

Ft. from S. Line

330 Ft. from E. Line

Ft. from W. Line

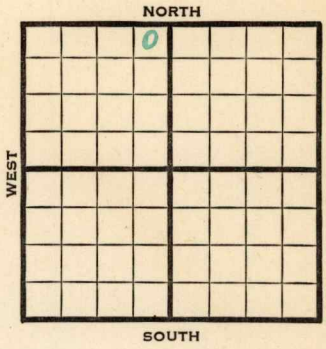


Elev. 1577

| 1942 | REPORT |
|---|---|
| 4/15 | Rotary. |
| 4/22 | 10" - 163' Drlg. 1678' |
| 4/29 | Fsg. 3144' |
| 5/6 | Miss. 3321-26' T.D. |
| | 6" - 3324' RUST. |
| 5/13 | T.D. 3376' Swab 69 oil in 4 hours |
| | show water. P.B. to 3363' |
| 5/20 | Shot 30 qts. 3344-60' 2900' oil. C.O. |
| 5/27 | " " " |
| | |
| 6/3 | Miss. 3321' |
| | 6" - 3324' |
| | T.D. 3376' |
| | P.B. to 3363' |
| | Shot 30 qts. 3344-60' |
| | Potential 204 bbls., pump. |
| | 37. Gravity |
| | |
| | COMPLETED |

Form 26 200 Bks. 5-41 McW.

KANSAS

Rice

Map No. 48 Sec. 36 Twp. 19 R. 6W

Well No. 2 Johns

Continental Company

FIRST REPORT Contractor

NE NW


330 Ft. from N. Line

_____ Ft. from S. Line

330 Ft. from E. Line

_____ Ft. from W. Line

SECTION PLAT

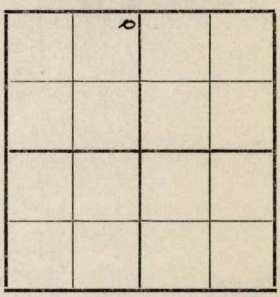

SMYRES POOL

Location _____

Rig up _____

Drilling and Remarks:

Rotary

RECORD

Cased _____ in., _____ ft.

Sand _____

Gas _____

Oil _____

Total Depth _____

PRODUCTION

1st 24 hrs. Nat. _____

1st 24 hrs. after shot _____

Gas _____ Cu. Ft.

Dry Hole _____

Abandoned _____

Date

APR 15 1942 19 S. J. LEWIS Scout

Form 26 200 Bks. 5-41 McW. Rice KANSAS

Map No. 48 Sec. 36 Twp. 19 R. 6W

Well No. 2 Johns

Continental Company

COMPLETED Contractor

NE NW


330 Ft. from N. Line

____ Ft. from S. Line

330 Ft. from E. Line

____ Ft. from W. Line

SECTION PLAT

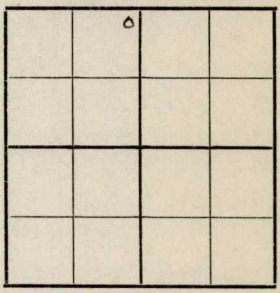

SMYRES POOL

Location ____

Rig up ____

Drilling and Remarks:

Miss 3321

6" @ 3324

PB 3363

309 to 3344-60

Pump 204 Bbl.

32° Gr.

RECORD

Cased ____ in., ____ ft.

Sand ____

Gas ____

Oil ____

Total Depth 3376

PRODUCTION

1st 24 hrs. Nat. ____

1st 24 hrs. after shot ____

Gas ____ Cu. Ft.

Dry Hole ____

Abandoned ____

Date

JUN 3 1942 19

S. J. LEWIS Scout