

KANSAS

Rice

FORM 51 5M 10-41 PETROL

Section 36 Township 19 Range 6-W

Well No. 1 Smyres


Company Nelson Drilling

Wildcat

NORTH

WEST

EAST

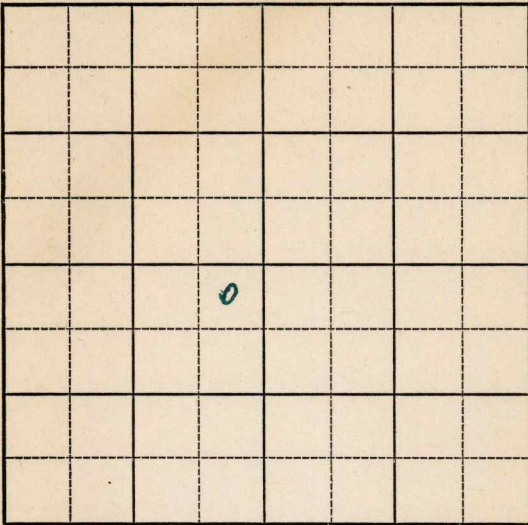

SOUTH

KANSAS

Rice

Sec. 36 Twp. 19 R. 6-W

Well No. #1 Smyres Farm

Nelson Drilling Company

(Wildcat)


330 Ft. from N. Line

 Ft. from S. Line

330 Ft. from E. Line

 Ft. from W. Line

Elev. 1603

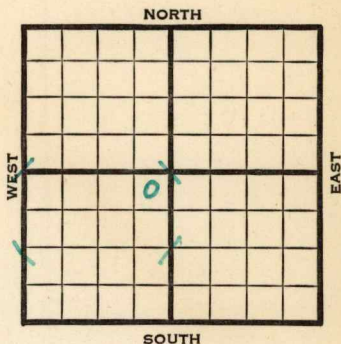

	REPORT
1941	
12/30	Surface Hole.
1942	
1/8	8" - 145' WOC.
1/15	Lans. 2778' Miss. 3321-24' T.D. 5" - 3321' RUST.
1/22	3339-45' 2800' oil 12 hours. 3345-50' - 3000' oil. T.D. 3354' Flow by heads. Bldg. tanks.
1/29	Flow 38 oil 41 minutes throught 1" choke on potential.
2/4	Miss. 3321' 5" - 3321' T.D. 3354' Bomb potential 4160 bbls. Maximum 3000 bbls. 37.5 Gravity
	COMPLETED


KANSAS

Rice

Map No. 48 Sec. 36 Twp. 19 R. 6WWell No. 1 SmyresNelson Drilling CompanyFIRST REPORT Contractor

NE SW

SECTION PLAT

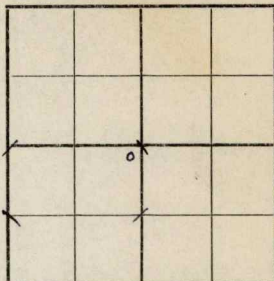330 Ft. from N. Line Ft. from S. Line330 Ft. from E. Line Ft. from W. Line

WILDCAT

Location Rig up Drilling and Remarks:

Surface Hole

RECORD

Cased in., ft.Sand Gas Oil Total Depth

PRODUCTION

1st 24 hrs. Nat. 1st 24 hrs. after shot Gas Cu. Ft.Dry Hole Abandoned

Date

DEC 30 1941 19S. J. LEWIS Scout

Rice

KANSAS

Map No. 48 Sec. 36 Twp. 19 R. 6WWell No. 1 SmyresNelson Drilling CompanyCOMPLETED Contractor

NE SW

330 Ft. from N. Line Ft. from S. Line330 Ft. from E. Line Ft. from W. Line

SECTION PLAT

	o		

WILDCAT

RECORD

Location Cased in., ft.Rig up Sand

Drilling and Remarks:

Gas Oil Total Depth 3354

PRODUCTION

1st 24 hrs. Nat. 1st 24 hrs. after shot Gas Cu. Ft.Dry Hole Abandoned

Date

FEB 4 1942 19

S. J. LEWIS Scout

375 gr

Miss 3321
 5" @ 3321
 Bon & P. Y. 4160
 May 3000