
FORM 51

Rice KANSAS

Section 36 Township 19 Range 6 W

Well No. # 7 Smyres

Company C R A

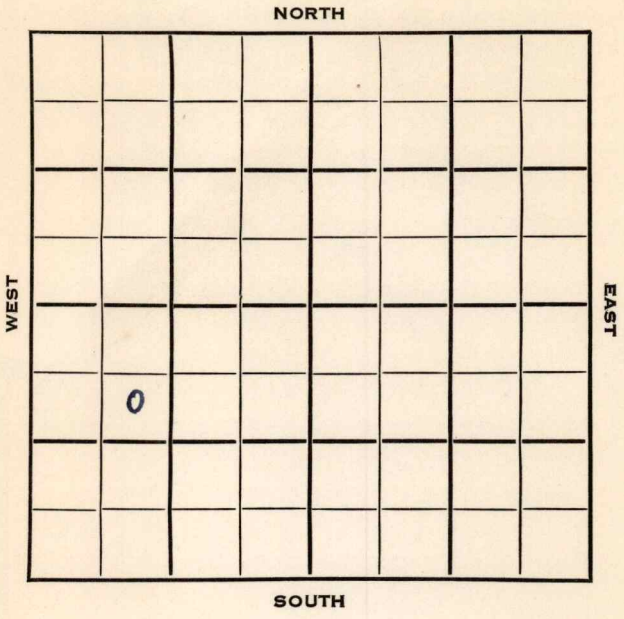

Rice KANSAS

SEC.	TWP.	R.
36	19	6W

WELL NO.

7 Smyres FARM
COMPANY

C R A
CONTRACTOR

Smyres Pool


990 Ft. from N. Line

Ft. from S. Line

Ft. from E. Line

990 Ft. from W. Line

SE NW SW

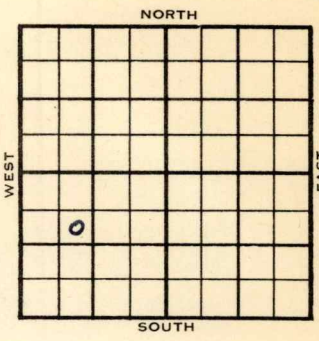

1953	ELEVATION 1586'	REPORT
10/21		Spudding
10/28		8" @ 135' Drlg.2967'
11/4		Lans 2773', Miss 3295' RTD 3297' 5" @3296'
11/11		DD 3308' 2 goph DD 3315 TD 2 go + 2 gwph A-frac
11/18		S/22 BO 5 hrs., POP
12/16		Spud 10-20-53 Oil Well TD 3315' 8" @ 135' Lans 2773', Miss 3295' TD 3297' 5" @ 3296' DD 3308', 2 goph DD 3315' 2 go 2 gwph A-frac S/22 bo 5 hrs. P/35.2 bo 19.8 wtr. Comp. 25 bopd 19 bw

DX-78

COMPLETED

FORM 275 FOR SALE BY KANSAS BLUE PRINT CO.


County Rice State Kansas

Sec. 36 (Blk. Twp.) 19 (Sur. Rge.) 6W Map No.

Operator C R A

Well No. 7 Farm Smyres

Elev. Location SE NW SW

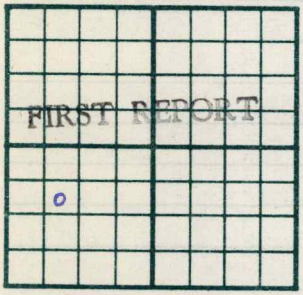

990 Ft. From N Line SW

990 Ft. From W Line Quarter

OCT 21 1953

1st. Report

Completion

Remarks

Spudding Date

Drlg. Data Smyres Pool

Spudding

J. G. McGEHEE

FORM 275 FOR SALE BY KANSAS BLUE PRINT CO.

County Rice State Kansas

Sec. 36 (Blk. Twp.) 19 (Sur. Rge.) 6W Map No.

Operator C R A

Well No. 7 Farm Smyres

Elev. 1586 Location SE NW SW



990 Ft. From N Line SW

990 Ft. From W Line Quarter

1st. Report

Completion DEC 16 1953

Remarks Smyres Pool

Spudding Date 10-20-53

Drlg. Data Oil well TD 3315

8" @ 135 Lans. 2773 Miss. 3295

TD 3297 5" @ 3296 DD 3308 2 goph

DD 3315 2 go 2 gwph A-frac

S/ 22 bo 5 hr. P/ 35.2 bo 19.8 wtr.

Comp. 25 bopd 19 bw

J. G. McGEHEE