Rice


Form 51—5M—9-28—27423

Map No. KANSAS Sec. 29 Twp. 19 R. 7W

Well No. 1-Cain Farm

Milmac etal Company

NORTH

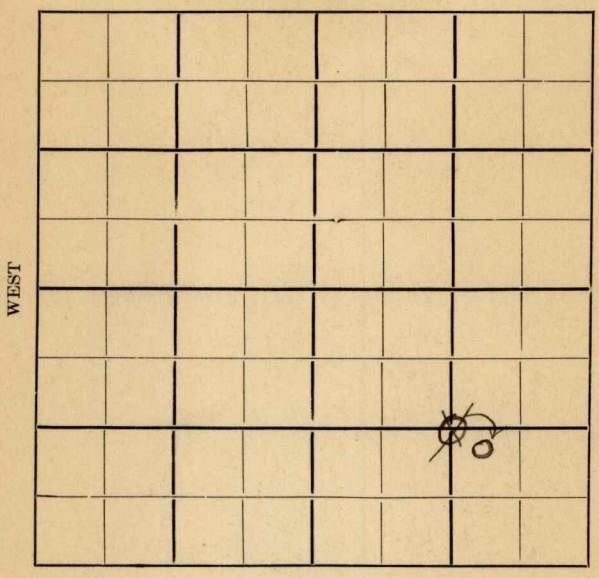

SOUTH

Location

Drilling Remarks

Rig Up

Drilling Remarks

RECORD

Cased ..... in. ..... ft.

Sand

Gas

Oil

Total Depth

PRODUCTION

1st 24 hrs. Nat.

1st 24 hrs. after shot

Gas. ..... cu. ft.

Dry Hole

Abandoned

Form 252A—5M—5-28—Mid-West

Rice

Map No. KANSAS Sec. 29 Twp. 19 R. 7W

Well No. 1-Sam Farm


Milmac et al Company

1140 Ft. from N. Line

~~1320~~ 990 Ft. from S. Line

~~1320~~ Ft. from E. Line

Ft. from W. Line

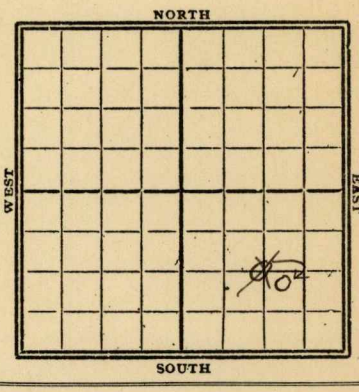

1929

Date	REPORT
6/26	Location
7/2	—
7/10	—
7/17	—
7/24	Rot'g
7/31	Rig up
8/7	Spdg 150'
8/14	SD. 150'
8/21	T.D. 595 - fish tools
8/28	Mlg 1200'
9/4	" 1605
9/11	" 1840
9/18	" 2180
9/25	" 2520
10/2	HFW at 2630' Drlg 2720'
10/9	SD. 2750'
10/16	Mlg 2755
10/23	WR 8" - 2850'
10/30	WR 8" - 3044'
11/6	Drlg 3045'
11/12	chat 3237-44' 1MM gas

11/18- Still S. D. 3244
11/20 — 2 of chat 3238
show gas base chat
at 3263 dly 3280
11/27 - W.R. 5" — 3595
12/4 ——
12/11 - sand 3602-10
HFW T.D. 3700 - SD
12/18 ——
12/23 ——
12/30 ——
1930
1/8- HFW 3602-10'
T.D. 3700'
Dry & Abandon

Form 26—1M Bks.—9-26

Map No. KANSAS Sec. 29 Twp. 19 R. 7W


29

Well No. 1 Cain

Milmac & Dale Company

.....Contractor

SECTION PLAT

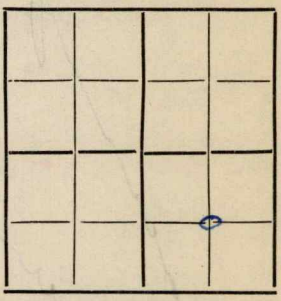

.....Ft. from N. Line

1320 Ft. from S. Line

1320 Ft. from E. Line

.....Ft. from W. Line

FIRST REPORTS

Location ✓

Rig up.....

Drilling and Remarks:

RECORD

Cased.....in., ...ft.

Sand.....

Gas.....

Oil.....

Total Depth.....

PRODUCTION

1st 24 hrs. Nat.....

1st 24 hrs. after shot.....

Gas.....Cu. Ft.

Dry Hole.....

Abandoned.....

Date

JUN 2 6 1929

.....192.....

S. J. LEWIS

.....Scout

Form 26—1M Bks.—9-28

Rice

Map No. KANSAS Sec. 29 Twp. 19 R. 2W.


29

Well No. 1 Cain

Milmac Dale Company

Contractor

SECTION PLAT

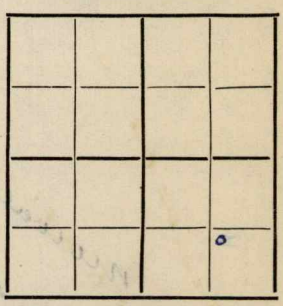

.....Ft. from N. Line

1140 Ft. from S. Line

990 Ft. from E. Line

.....Ft. from W. Line

CORRECTION

Location.....

Rig up.....

Drilling and Remarks:

Rejected
C SE.

RECORD

Cased.....in., ...ft.

Sand.....

Gas.....

Oil.....

Total Depth.....

PRODUCTION

1st 24 hrs. Nat.....

1st 24 hrs. after shot.....

Gas.....Cu. Ft.

Dry Hole.....

Abandoned.....

Date

NOV 20 1928 192.....

S. J. LEWIS Scout

Form 26—M. Bks.—9-28

Map No. KANSAS Sec. 29 Twp. 19 R. 7 W


49

Well No. 1 Cain

Wilmac Edale Company

Contractor

SECTION PLAT

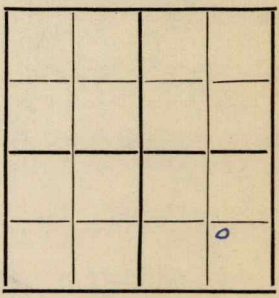

..... Ft. from N. Line

1140 Ft. from S. Line

990 Ft. from E. Line

..... Ft. from W. Line

ABANDONED

Location.....

Rig up.....

Drilling and Remarks:

HFW 3602-10

RECORD

Cased ..... in., ... ft.

Sand.....

Gas.....

Oil.....

Total Depth 3700

PRODUCTION

1st 24 hrs. Nat.....

1st 24 hrs. after shot.....

Gas..... Cu. Ft.

Dry Hole.....

Abandoned.....

Date

JAN 8 1930

192.....

S. J. LEWIS Scout