


KANSAS

Section 1 Township 19 Range 8W

Well No. #1 Behnke "B"

Company Derby Drlg. Company

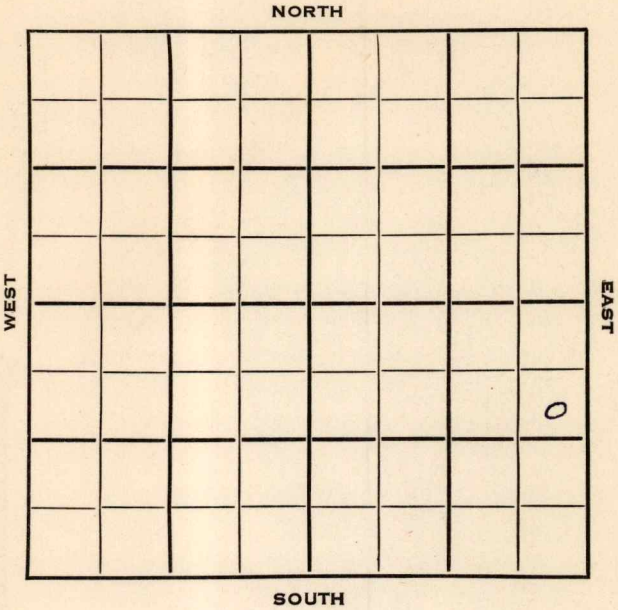

Rice

KANSAS

1

Twp. 19

R. 8W

Well No. #1 Behnke "B" Farm

Derby Drlg.

Company

Derby Drlg. - Contr.

Contractor


990 Ft. from N. Line

Ft. from S. Line

330 Ft. from E. Line

Ft. from W. Line

SE NE SE

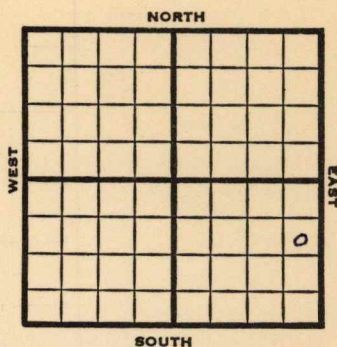

1953 Elev. 1758' REPORT

3/4 Spudded 2/25/53
8" @ 195
Drlg. 2605

3/11 Spud 2-25-53 D & A TD 3342
8" @ 195 Heeb 2682 Br. lime 2816
Lans. 2850
DST 2862-2914 open 1 hr. rec 35' mud
100# Cong. 3209 Arb. 3307
DST 3314-42 open 1 hr. rec 1800' sul
wtr. 1350# TD 3342
D & A

ABANDONED

County Rice State Kansas
 Sec. 1 (Blk.) 19 (Sur.) 8W Map No.
 Operator Derby Drlg.
 Well No. 1 Farm Behnke "B"
 Elev. Location SE NE SE

FIRST REPORT

990 Ft. From N Line SE
 330 Ft. From E Line Quarter
 1st. Report MAR 4 1953
 Completion
 Remarks Derby Drlg. - Contr.
 Spudding Date 2-25-53

Drlg. Data

8" @ 195 drlg. 2605


J. G. McGEHEE

County Rice State Kansas
 Sec. 1 (Blk.) 19 (Sur.) 8W Map No.

Operator Derby Drlg.

Well No. 1 Farm Behnke "B"

Elev. 1758 Location SE NE SE

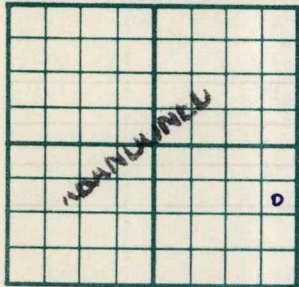

990 Ft. From N Line SE

330 Ft. From E Line Quarter

1st. Report

Completion MAR 11 1953

Remarks

Derby Drlg. - Contr.

Spudding Date 2-25-53

Drlg. Data D & A TD 3342

8" @ 195 Heeb. 2682 Br. lime 2816

Lans. 2850 DST 2862-2914 open 1 hr.

Rec. 35' mud 100# Cong. 3209

Arb. 3307 DST 3314-42 open 1 hr.

Rec. 1800' sul.wtr. 1350# TD 3342

D & A

J. G. McGEHEE