

O.W.W.O.

KANSAS


Form 51-5M 5-37 Petrol

Rice

Section 1 Township 19 Range 8-W

Well No. 1 Connery "A"

Company Florney & Williams
~~Continental~~

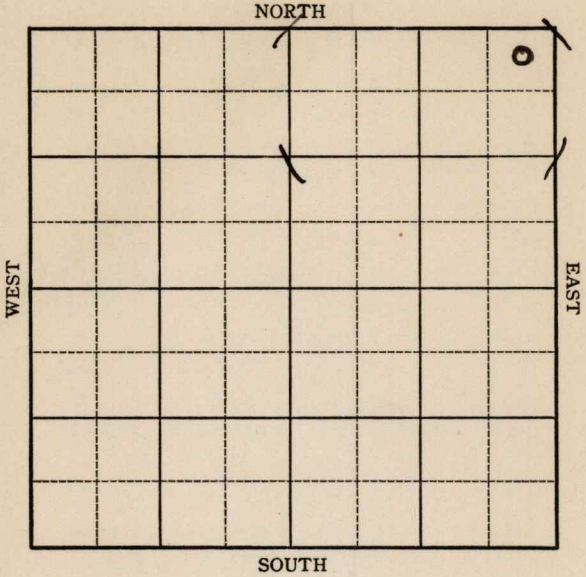

1938

1/19 7" @ 3251'.

Arb. 3250'.

T.D. 3258'.

2000 acid.

Potential 962 oil & 153 water.

COMPLETED

1951

O.W.W.O.

4/4 Arb. 3250', 7" @ 3250' TD 3258'

CO & set 4½" @ 3230'

4/11 D&A TD 3258'

Simp 3235' Arb. 3250

7" @ 3250 OTD 3258

CO & set 4½" @ 3230

24/3102-08 24/3164-74 36/3198-3208

D&A

ABANDONED

Rice

KANSAS

Map No. 49 Sec. 1 Twp. 19 R. 8W

Well No. 1 Connery "A"

Continental Company

Contractor

FIRST REPORT

NE/C

SECTION PLAT

330 Ft. from N. Line

_____ Ft. from S. Line

330 Ft. from E. Line

_____ Ft. from W. Line

Location _____

RECORD

Rig up _____

Cased _____ in., _____ ft.

Drilling and Remarks:

Sand _____

RUR

Gas _____

Oil _____

Total Depth _____

PRODUCTION

1st 24 hrs. Nat. _____

1st 24 hrs. after shot _____

Gas _____ Cu. Ft.

Dry Hole _____

Abandoned _____

Date

DEC 8 - 1937 19

H. D. Hatfield Scout

Rice

Map No. 49 Sec. 1 Twp. 19 R. 8W

Well No. 1 Connery "A"

Continental Company

Contractor

COMPLETED

NE/C

SECTION PLAT

330 Ft. from N. Line

_____ Ft. from S. Line

330 Ft. from E. Line

_____ Ft. from W. Line

			0

Location _____

Rig up _____

Drilling and Remarks:

2000 acid

got 962 oil

153 water

RECORD

Cased 7 in. 3251 ft.

Sand ARB 3250

Gas _____

Oil _____

Total Depth 3258

PRODUCTION

1st 24 hrs. Nat. _____

1st 24 hrs. after shot _____

Gas _____ Cu. Ft.

Dry Hole _____

Abandoned _____

Date

JAN 19 1938 19

H. D. Hatfield Scout

