

KANSAS

FORM 51 5M 1-42 PETROL


Rice

Section 36 Township 19 Range 6-W

Well No. 1 Smyers

Company Westgate Greenland

NORTH Smyres Pool

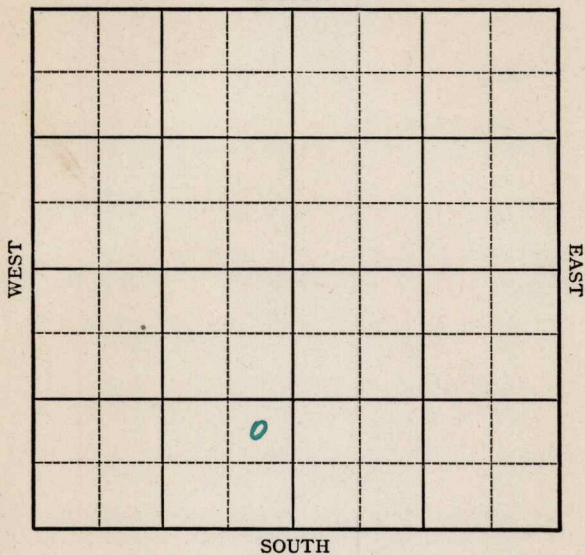

Map No. 48 Sec. 36 Twp. 19 R. 6WWell No. 1 SmyersWestgate Greenland


Company

FIRST REPORT

Contractor

NE SE SW

SECTION PLAT

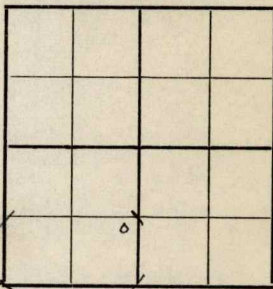 Ft. from N. Line990 Ft. from S. Line330 Ft. from E. Line Ft. from W. Line

SMYRES POOL

Location XXRig up

Drilling and Remarks:

RECORD

Cased in., ft.Sand Gas Oil Total Depth

PRODUCTION

1st 24 hrs. Nat. 1st 24 hrs. after shot Gas Cu. Ft.Dry Hole Abandoned

Date

MAR 4 1942

19

S. J. LEWIS Scout

Rice

KANSAS

Map No. 48 Sec. 36 Twp. 19 R. 6WWell No. 1 SmyresWestgate Greenland CompanyCOMPLETED Contractor

NE SE SW

SECTION PLAT

 Ft. from N. Line990 Ft. from S. Line330 Ft. from E. Line Ft. from W. Line

SMYRES POOL

Location Rig up

Drilling and Remarks:

*Miss 3332**7" C 3338**Bony & P 3125**May 3000**325 Gr*

RECORD

Cased in., ft.Sand Gas Oil Total Depth 3359

PRODUCTION

1st 24 hrs. Nat. 1st 24 hrs. after shot Gas Cu. Ft.Dry Hole Abandoned

Date

APR 8 1942 19S. J. LEWIS

Scout