


Section 36 Township 19 Range 6W

Well No. #2 Smyers

Company Westgate-Greenland

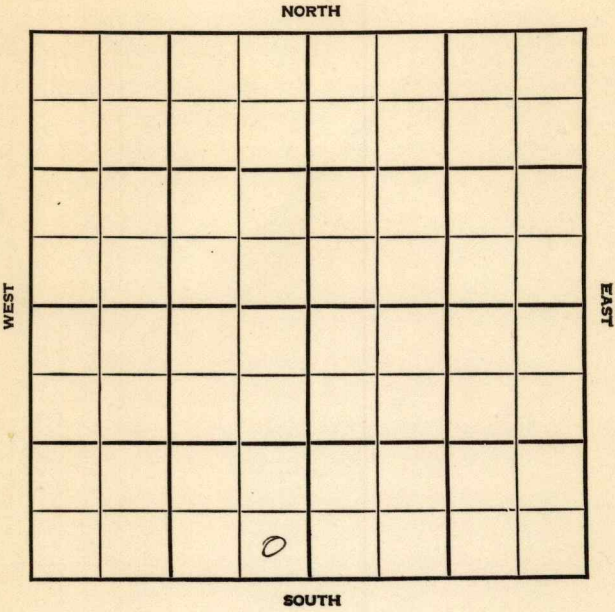

KANSAS Rice

V

Sec. 36 Twp. 19 R. 6W

Well No. #2 Smyers Farm

Westgate-Greenland Company

Smyers


 Ft. from N. Line

330 Ft. from S. Line

330 Ft. from E. Line

 Ft. from W. Line

SE SW

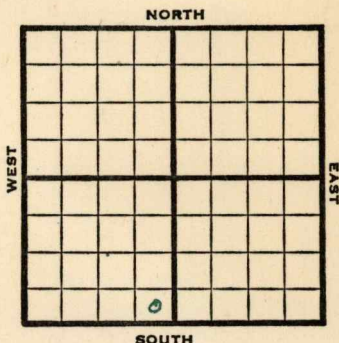

1947

Elev. 1598' REPORT

11/19 RUR

11/25 8" @ 173'
Drlg. 2685'

12/3 Chat 3334'
TD 3336'
5" @ 3335'
RUST

12/10 "

12/17 "

1948

1/7 Chat 3334'
5" @ 3335'
Pump 149 Pot.
Gr. 390
Total Depth 3358'

COMPLETED

Kansas

Map No. _____ Sec. 36 Twp. 19 R. 6WWell No. 2 SmyersWestgate-Greenland Company

FIRST REPORT

Contractor

SE SW

SECTION PLAT

_____ Ft. from N. Line

330 Ft. from S. Line330 Ft. from E. Line

_____ Ft. from W. Line

Rice County

Location _____

Rig up _____

Drilling and Remarks:

R U R

RECORD

Cased _____ in., _____ ft.

Sand _____

Gas _____

Oil _____

Total Depth _____

PRODUCTION

1st 24 hrs. Nat. _____

1st 24 hrs. after shot _____

Gas _____ Cu. Ft.

Dry Hole _____

Abandoned _____

Date

NOV 19 1947

19

S. J. LEWIS

Scout

Kansas


Map No. 48 Sec. 36 Twp. 19 R. 6WWell No. 2 SmyresWestgate-Greenland

Company

COMPLETE

Contractor

SE SW

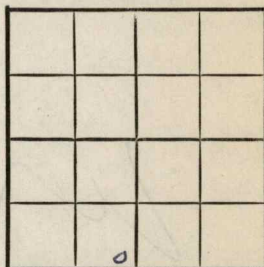E. 1598
SECTION PLAT Ft. from N. Line330 Ft. from S. Line330 Ft. from E. Line Ft. from W. Line

Rice County

Location Rig up

Drilling and Remarks:


RECORD

Cased in., ft.Sand Gas Oil Total Depth 83335

PRODUCTION

1st 24 hrs. Nat. 1st 24 hrs. after shot Gas Cu. Ft.Dry Hole Abandoned

Date

JAN 7 1948 19

S. J. LEWIS

Scout