


FORM 51 25M 3-49 PETROL

Section 36 Township 19 Range 6-WWell No. #3 SmyersCompany Westgate-Greenland
Smyers. Pool

NORTH

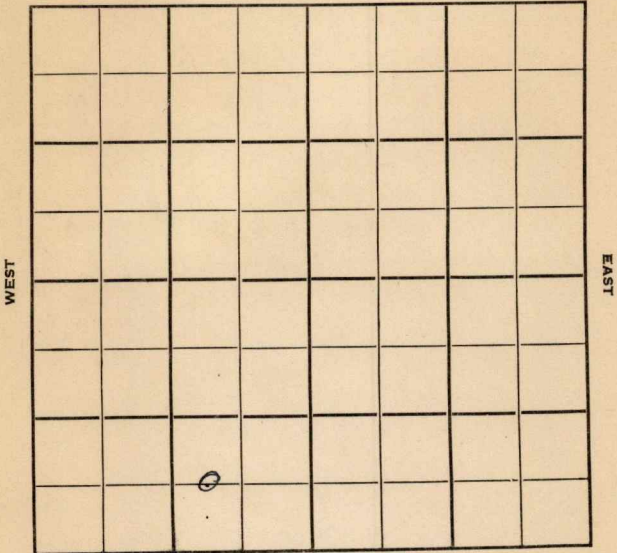

SOUTH

Rice

KANSAS

Sec. 36 Twp. 19 R. 6W

Well No. #3 Smyers Farm

Westgate-Greenland

Smyers Pool Company

Contractor


Ft. from N. Line

660' Ft. from S. Line

990' Ft. from E. Line

Ft. from W. Line

C W L SE SW

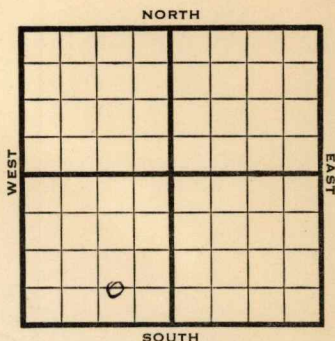

1949

Elev. 1596'

REPORT

10/26	Location
11/1	8" @ 149' Drlg. 1810'
11/9	Chat 3310' Lost Circulation @ 3517'
11/16	Arb. 3760' TD 4073' 5" @ 3842'
11/23	"
11/29	"
12/7	"
12/14	Arb 3760' 5" @ 3842' SWD TD 4073' ABANDONED

Map No. _____ Sec. 36 Twp. 19 R. 6W

Well No. 3 Smyers

Westgate-Greenland Company

Contractor

C W L SE SW

**FIRST REPORT
SECTION PLAT**

_____ Ft. from N. Line

660 Ft. from S. Line

990 Ft. from E. Line

_____ Ft. from W. Line

Rice County

Location X

Rig up _____

Drilling and Remarks:

RECORD

Cased _____ in., _____ ft.

Sand _____

Gas _____

Oil _____

Total Depth _____

PRODUCTION

1st 24 hrs. Nat. _____

1st 24 hrs. after shot _____

Gas _____ Cu. Ft.

Dry Hole _____

Abandoned _____

Date

OCT 26 1949

19

S. J. LEWIS

Scout

Kansas

Smyres Pool

6W

Map No. _____ Sec. 36 Twp. 19 R. _____Well No. 3 Smyres_____
Westgate-Greenland Company

ABANDONED

Contractor

C W L SE SW

E1, 1596
SECTION PLAT_____
Ft. from N. Line660 Ft. from S. Line990 Ft. from E. Line_____
Ft. from W. Line

Rice County

Location _____

Rig up _____

Drilling and Remarks:

Cr 837605" C 3842BWD

RECORD

Cased _____ in., _____ ft.

Sand _____

Gas _____

Oil _____

Total Depth 4073

PRODUCTION

1st 24 hrs. Nat. _____

1st 24 hrs. after shot _____

Gas _____ Cu. Ft.

Dry Hole _____

Abandoned _____

Date

DEC 14 1949

19

S. J. LEWIS

Scout