

KANSAS


FORM 51 IOM 12-46 PETROL

Rice

Section 36 Township 19 Range 6-W

Well No. #4 Smyres

Company Mallard Drlg

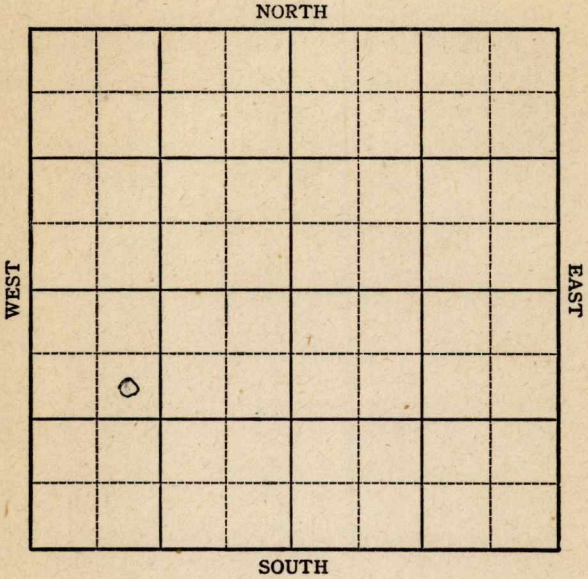

KANSAS

Smyres Pool

Sec. 36 Twp. 19 R. 6-W

Well No. 4 Smyres Farm

Mallard Drlg. Company


SE NE SW

990 Ft. from N. Line

_____ Ft. from S. Line

_____ Ft. from E. Line

990 Ft. from W. Line

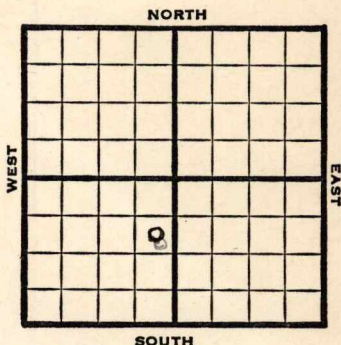

Rice County

1947 1604 REPORT

2-12-10" @ 148
Miss. 3337
TD 3356
7" @ 3339

2/19 " "

2/26 Miss 3337'
7" @ 3339
Pump 792 Pot
Grav. 39.6
TD 3359'


COMPLETED

Kansas

Map No. 48 Sec. 36 Twp. 19 R. 6WWell No. 4 SmyresMallard Drlg. CompanyFIRST REPORT Contractor

SE NE SW

SECTION PLAT

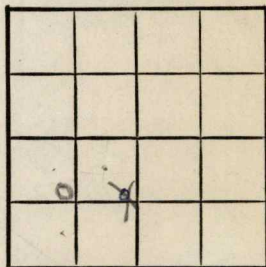990 Ft. from N. Line Ft. from S. Line Ft. from E. Line990 Ft. from W. LineRice CountyLocation Rig up

Drilling and Remarks:

10" @ 148

Miss. 3337

TD 3356

7" @ 3339

RECORD

Cased in., ft.Sand Gas Oil Total Depth

PRODUCTION

1st 24 hrs. Nat. 1st 24 hrs. after shot Gas Cu. Ft.Dry Hole Abandoned

Date

FEB 12 1947

19

S. J. LEWIS

Scout

KANSAS

Smyres Pool

Map No. 78 Sec. 36 Twp. 19 R. 6W

Well No. 4 Smyres

Mallard Drlg.

Company

COMPLETE

Contractor

SE NE SW


E11604
SECTION PLAT

990 Ft. from N. Line

_____ Ft. from S. Line

_____ Ft. from E. Line

990 Ft. from W. Line

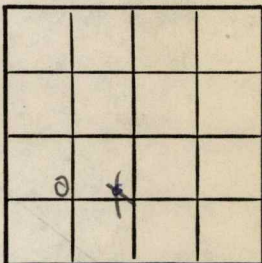

Rice County

Location _____

Rig up _____

Drilling and Remarks:

Miss 3332
7" @ 3335
Prod 792 BX

89-6-9

RECORD

Cased _____ in., _____ ft.

Sand _____

Gas _____

Oil _____

Total Depth 3305

PRODUCTION

1st 24 hrs. Nat. _____

1st 24 hrs. after shot _____

Gas _____ Cu. Ft.

Dry Hole _____

Abandoned _____

Date

FEB 26 1947

19

S. J. LEWIS

Scout