


Rice

KANSAS

Section 6 Township 19 Range 7-W

Well No. 2 H. Warner

Company Continental

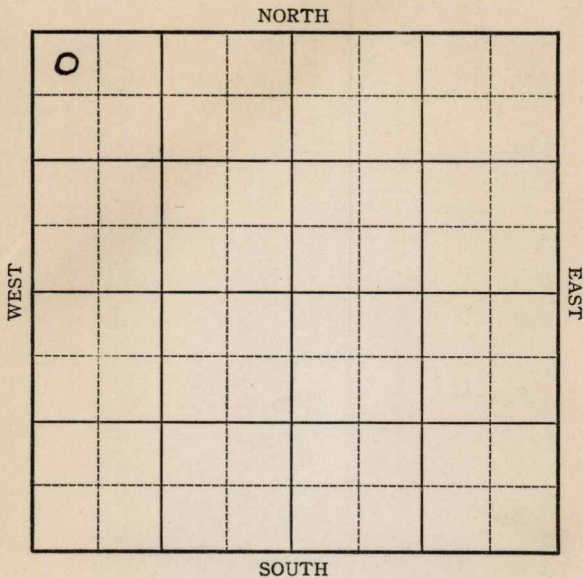

1938

1/5

7" @ 3238'.

Arb. 3237'.

T.D. 3253'.

2000 acid.

Potential 2016 bbls.

COMPLETED

Rice

KANSAS

Map No. 49 Sec. 6 Twp. 19 R 7WWell No. 2 H. WarnerContinental

Company

Contractor

FIRST REPORT

NW/C

330 Ft. from N. Line

_____ Ft. from S. Line

_____ Ft. from E. Line

330 Ft. from W. Line

SECTION PLAT

D			

Location _____

Rig up _____

Drilling and Remarks:

RUR

RECORD

Cased _____ in., _____ ft.

Sand _____

Gas _____

Oil _____

Total Depth _____

PRODUCTION

1st 24 hrs. Nat. _____

1st 24 hrs. after shot _____

Gas _____ Cu. Ft.

Dry Hole _____

Abandoned _____

Date

NOV 3 1937 19

H. D. Hatfield

Scout

Rice

KANSAS

Map No. 49 Sec. 6 Twp. 19 R. 7WWell No. 2 H. WarnerContinental

Company

Contractor

COMPLETED

NW/C

SECTION PLAT

0			

330 Ft. from N. Line Ft. from S. Line Ft. from E. Line330 Ft. from W. LineLocation Rig up

Drilling and Remarks:

2000 AcidPT 2016.

RECORD

Cased 7 in., 3238 ft.Sand Arb 3237Gas Oil Total Depth 3253

PRODUCTION

1st 24 hrs. Nat. 1st 24 hrs. after shot Gas Cu. Ft.Dry Hole Abandoned

Date

JAN 5 - 1938 19H. D. Hatfield Scout