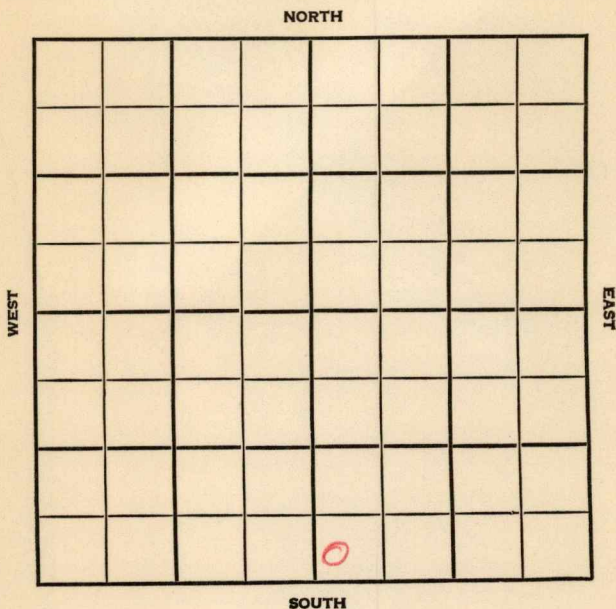


Section 23 Township 19 Range 7WWell No. #1 RifeCompany Nadel & Gussman

Rice

KANSAS

SEC.

TWP.

R.

23

19

7W

WELL NO.

1 Rife

FARM

COMPANY

Nadel & Gussman

CONTRACTOR

Reserve Drlg.


Wildcat

_____ Ft. from N. Line

_____ Ft. from S. Line

_____ Ft. from E. Line

_____ Ft. from W. Line

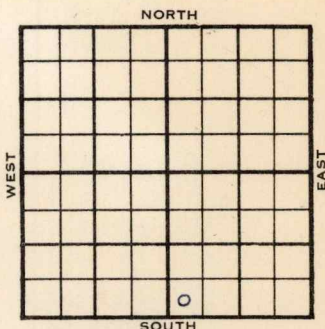

SW SW SE

1955

ELEVATION

1718'

REPORT

5/26

Comm 5-16-55
8" @ 157 w/80

WOC

6/10

Comm 5-16-55

H 2705', B1 2847, L. 2883, Miss 3303,
Misener 3543 V 3592

Simp Sd 3630, A 3695, TD 3730

8" @ 157/80 DST 2981-3003, open 1
hr Rec 1080' sw 1160/15"

D & A

ABANDONED

Twp. Pool

Co. Forest


FORM 513 REV. SUNRAY

FIRST REPORT

County Rice Elev. 1718
Sec. 23 Twp. 19 Rge. 7W
Company Nadel & Gussman
Farm Name Rife No. 1

TOPS	DEPTH	DATUM
Cim. Anhydrite		
Ft. Riley		
Howard		
Topeka		
Heebner Sh.		
Toronto Ls.		
Brown Lime		
Lansing		
Kans. City		
B. K. C.		
Congl.		
Miss.		
Kinderhook		
Misener		
Hunton		
Sylv. Maquo		
Viola		
Simpson		
Smp.		
Gorham		
Arbuckle		
Basal Sand		
Pre. Cam.		
T. D.		

Loc. in Section
SW SW SE
Drlg. Contr. Reserve Drlg.
Pool Wildcat

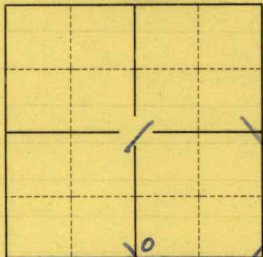

Date Comm. 5-16-55
Date Comp.

8" @ 157 w/ 80 WOC

K-12

County Rice Elev. 1718Sec. 23 Twp. 19 Rge. 7WCompany Nadel & GussmanFarm Name Rife No. 1

TOPS

DEPTH

LOG

DATUM

Loc. in Sec.

Anh.

Tp.

H.

Tr.

Dg.

Bl.

L.

K.C.

B.K.C.

Ce.

C.

M. 155

M. 156

K.

Mz.

Me.

V.

S. imp sd.

S.

A.

R.

P.E.

G.

T.D.

2705

987

2847

1129

2883

1165

3303

1585

3543

1825

3592

1874

3630

1912

3695

1977

3730

SW SW SE

Geol.

Contr.

Reserve Drlg

Pool

Wildcat

ABANDONED

Date Comm. 5-16-55 JUN 1 1955

8" @ 157/80 DST 2981-3003 open 1 hr.

Rec. 1080' sw 1160/15"

D & A