

KANSAS

Russell

Form 51-5M-7-40-Palace

Section 8 Township 15 Range 13-W

Well No. 13 Detrick (Twin #2)


Company Carter Oil

Coralena pool

NORTH

WEST

EAST

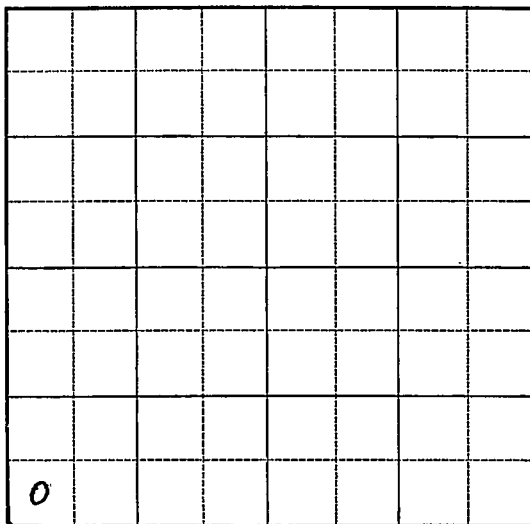

SOUTH

Sec. 8 Twp. 15 R. 13-W

Well No. #13 Detrich (Twin #2) Farm

Carter Oil

Company

(Coralena)


Ft. from N. Line

330 Ft. from S. Line

Ft. from E. Line

380 Ft. from W. Line

Elev. 1782

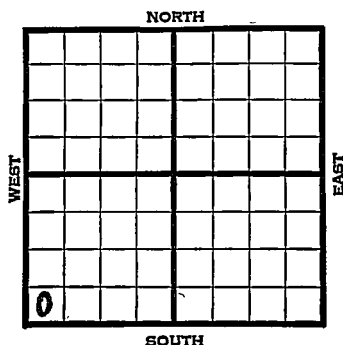[illegible]

1941

1/13

Lans. 2931'

5" - 2936'

1½ M gas 2953-55

1000 acid

5 M gas

10,000 acid

T.D. 2979'

Flo. 22 oil P.H. 9 hrs

Pmp 44 bbls in 8 hrs

Phy. pot. 132

39° Grav.

COMPLETED

Map No. 72 Sec. 8 Twp. 15 R. 13WWell No. 13 Detrich (Twin #2)Carter Oil Company**FIRST REPORT** Contractor

SW/C

SECTION PLAT

 Ft. from N. Line330 Ft. from S. Line Ft. from E. Line380 Ft. from W. Line

CORALENA POOL

Location Rig up

Drilling and Remarks:

8" - 222

Drlg. 1000

RECORDCased in., ft.Sand Gas Oil Total Depth **PRODUCTION**1st 24 hrs. Nat. 1st 24 hrs. after shot Gas Cu. Ft.Dry Hole Abandoned

Date

MAY 21 1941 19

S. J. LEWIS Scout

KANSASMap No. 73 Sec. 8 Twp. 15 R. 13WWell No. 13 Detrich (Twin #2)Carter Oil Company

Contractor

COMPLETED**SECTION PLAT**

SW/C

Ft. from N. Line

330 Ft. from S. Line

Ft. from E. Line

380 Ft. from W. Line**CORALENA POOL**

Location _____

Rig up _____

Drilling and Remarks:

*Lano 2931**5" 2936**1 1/2 m gas 2953-55**1000 acid**5 m gas**10000 acid**Fls. 22 oil RH 9 hrs Pump**Phy Pot 132**39° grav.***RECORD**

Cased _____ in., _____ ft.

Sand _____

Gas _____

Oil _____

Total Depth 2979**PRODUCTION**

1st 24 hrs. Nat. _____

1st 24 hrs. after shot _____

Gas _____ Cu. Ft.

Dry Hole _____

Abandoned _____

Date

AUG 13 1941

19

S. J. LEWIS Scout