

KANSAS


Rice

FORM 51 5M PETROL

Section 1 Township 19 Range 8W

Well No. 1 Smith

Company Wolf Creek etal

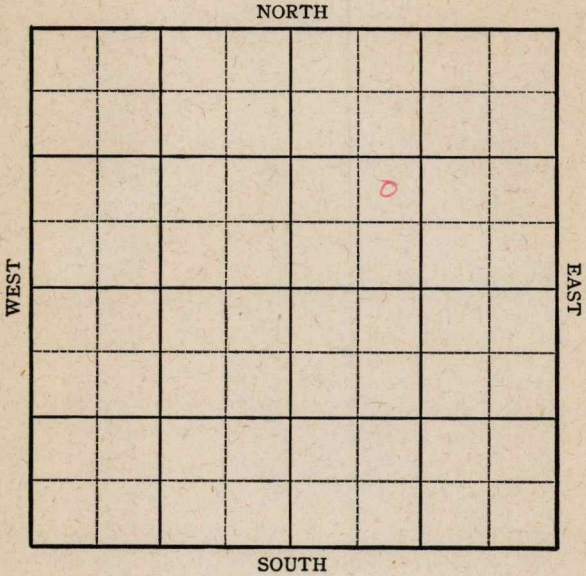

KANSAS Rice

Sec. 1 Twp. 19 R. 8-W


Well No. #1 Smith Farm _____
Wolf Creek et al Company _____

_____ Ft. from N. Line

990 Ft. from S. Line

_____ Ft. from E. Line

990 Ft. from W. Line

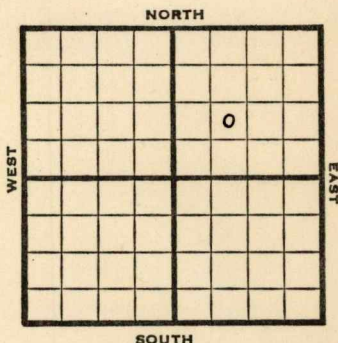

NE SW NE

1945

Elev. 1754

REPORT

9/26 RUR

10/3 8" @ 217 WOC

10/10 Drlg. 2327'

10/17 **Lans. 2852**

Arb. 3295

TD 3301'

ABANDONED

KANSAS

Kansas

Pool Name Geneseo

Map No. 49 Sec. 1 Twp. 19 R. 8W

Well No. 1 Smith

Wolf Creek etal Company

ABANDONED

Contractor

NE SW NE

E. 11754
SECTION PLAT

_____ Ft. from N. Line

990 Ft. from S. Line

_____ Ft. from E. Line

990 Ft. from W. Line

		o	

Rice County

Location _____

Rig up _____

Drilling and Remarks:

4 and 2532
Ar 8295

RECORD

Cased _____ in., _____ ft.

Sand _____

Gas _____

Oil _____

Total Depth 9301

PRODUCTION

1st 24 hrs. Nat. _____

1st 24 hrs. after shot _____

Gas _____ Cu. Ft.

Dry Hole _____

Abandoned _____

Date

OCT 17 1945 19

S. J. LEWIS

Scout