


Section 28 Township 19 Range 8- W

Well No. #1 Ross

Company Ed Swearer et al

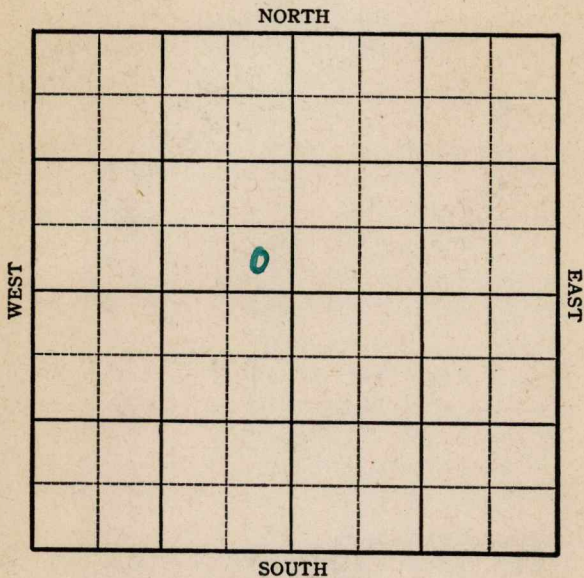

KANSAS

Rice

Sec. 23 Twp. 19 R. 8-W

Well No. #1 Ross Farm
Ed Swearer et al Company


 Ft. from N. Line

330 Ft. from S. Line

330 Ft. from E. Line

 Ft. from W. Line

SE NW

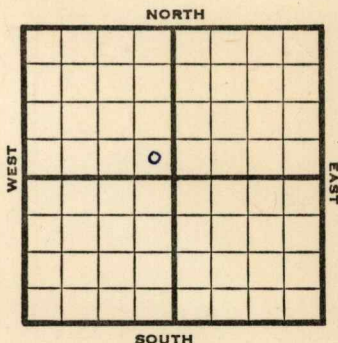

1945

Elev. 1751

REPORT

12/12 Location

12/20 "

12/29 R.U.R.

1946

1/10 8" - 225'

Drlg. 2965'

1/16 **Lans 2950**

Misener 3465

Viola 3480

Simp. 3527

Arb. 3585

TD 3617'

ABANDONED


KANSASKansas Pool Name WildcatMap No. K-49 Sec. 23 Twp. 19 R. 8WWell No. 1 RossEd Swearer et al

Company

FIRST REPORT

Contractor

SE NW

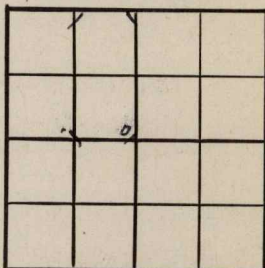SECTION PLAT Ft. from N. Line330 Ft. from S. Line330 Ft. from E. Line Ft. from W. Line

Rice County

Location xRig up

Drilling and Remarks:

RECORDCased in., ft.Sand Gas Oil Total Depth **PRODUCTION**1st 24 hrs. Nat. 1st 24 hrs. after shot Gas Cu. Ft.Dry Hole Abandoned

Date

DEC 1 2 1945 19S. J. LEWIS

Scout

KANSASKansas Pool Name WildcatMap No. 49 Sec. 23 Twp. 19 R. 8WWell No. 1 RossEd Swearer et al

Company

ABANDONED

Contractor

SE NW

E. 1/2
SECTION PLAT

Ft. from N. Line

330 Ft. from S. Line330 Ft. from E. Line

Ft. from W. Line

Rice County

Location

Rig up

Drilling and Remarks:


RECORD

Cased _____ in., _____ ft.

Sand _____

Gas _____

Oil _____

Total Depth 3617

PRODUCTION

1st 24 hrs. Nat. _____

1st 24 hrs. after shot _____

Gas _____ Cu. Ft.

Dry Hole _____

Abandoned _____

Date

JAN 1 6 1946 19S. J. LEWIS

Scout