


KANSAS

Rice

Section 10 Township 19 Range 8W

Well No. 1 Bolton "A"

Company Chalmette Pet.

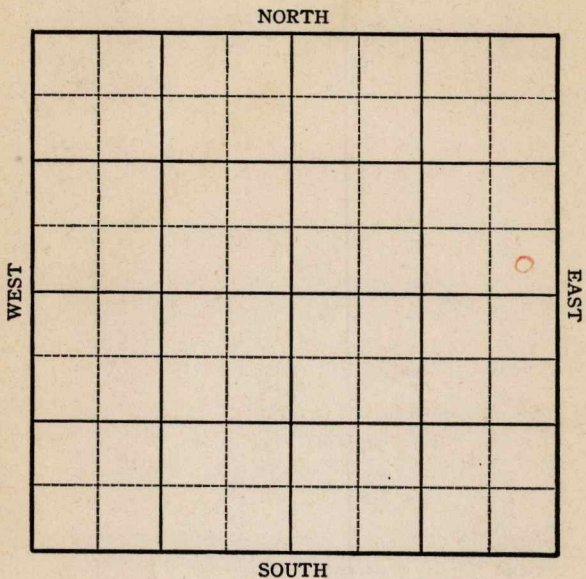

KANSAS

Rice

Sec. 10 Twp. 19 R. 8-W

Well No. #1 Bolton "A" Farm


Chalmette Pet. Company

 Ft. from N. Line

330 Ft. from S. Line

330 Ft. from E. Line

 Ft. from W. Line

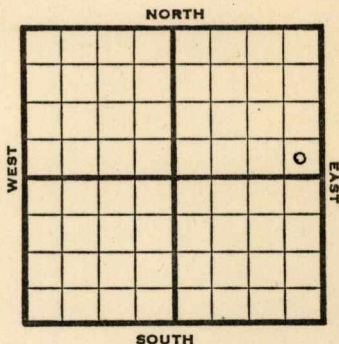

SE NE

1945 **Elev. 1756'** REPORT

11/28 Location

12/5 RUR

12/12 8" @ 210

Drlg. 1650'

12/20 **Lans 2844'** Drlg. 3210'

12/28 **Arb. 3206**

TD 3300'

ABANDONED

KANSASKansas Pool Name SilicaMap No. 49 Sec. 10 Twp. 19 R. 8WWell No. 1 Bolton "A"


Chalmette Pet.

Company

FIRST REPORT

Contractor

SE NE

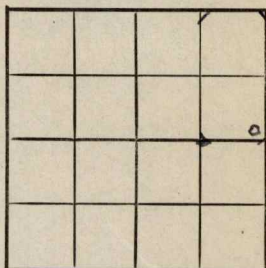SECTION PLAT

Ft. from N. Line

330 Ft. from S. Line330 Ft. from E. Line

Ft. from W. Line

Rice County

Location X

Rig up

Drilling and Remarks:

RECORD

Cased _____ in., _____ ft.

Sand _____

Gas _____

Oil _____

Total Depth _____

PRODUCTION

1st 24 hrs. Nat. _____

1st 24 hrs. after shot _____

Gas _____ Cu. Ft.

Dry Hole _____

Abandoned _____

Date

NOV 28 194519S. J. LEWIS

Scout

KANSAS

Kansas

Pool Name WildcatMap No. K-49 Sec. 10 Twp. 19 R. 8WWell No. 1 Bolton "A"Chalmette Pet.

Company

ABANDONED

Contractor

SE NE

E. 1256

SECTION PLAT

			0

Ft. from N. Line330 Ft. from S. Line330 Ft. from E. LineFt. from W. LineRice County

Location

Rig up

Drilling and Remarks:

See 83206

RECORD

Cased _____ in., _____ ft.

Sand _____

Gas _____

Oil _____

Total Depth 2300

PRODUCTION

1st 24 hrs. Nat. _____

1st 24 hrs. after shot _____

Gas _____ Cu. Ft.

Dry Hole _____

Abandoned _____

Date

DEC 28 194519S. J. LEWIS

Scout