Rice


DX 78-1

KANSAS

Section 36 Township 19 Range 8W

Well No. #1 Knight

Company Drillers Production

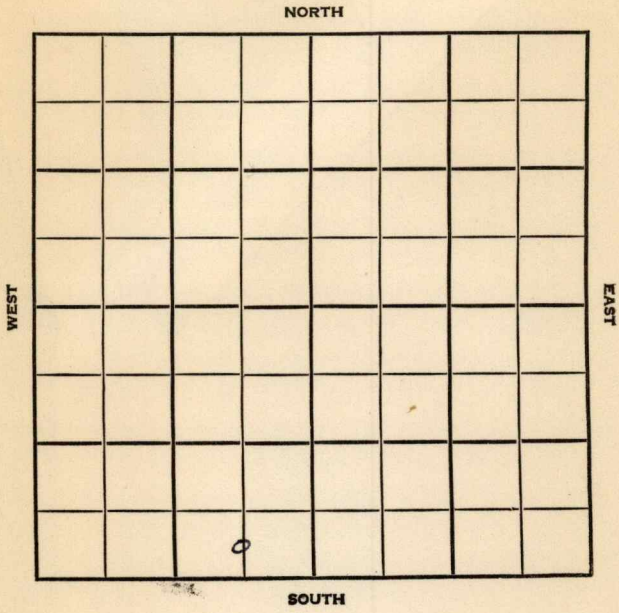

Rice KANSAS

SEC.	TWP.	R.
36	19	8W

WELL NO.

1 Knight FARM

COMPANY

Drillers Produciton

CONTRACTOR

Tom Allan

Wildcat


_____ Ft. from N. Line

330 Ft. from S. Line

660 Ft. from E. Line

_____ Ft. from W. Line

C S/2 SE SW

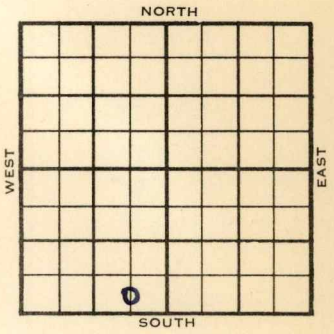

	ELEVATION	REPORT
1955	1738'	
1/12	Location	
2/2	Spud 1-13-55 - D&A TD 3415' 8" @ 145' Tarkio 2086', Br lime 2838', Lans. 2877', B KC 3186', Cong. 3198', Kh. 3212', Maq. 3354', Viola 3369', Simp sh 3405', Simp. dolo 3409' TD 3415' D&A	

ABANDONED

DX-78

FORM 275 FOR SALE BY KANSAS BLUE PRINT CO.


County Rice State Kansas

Sec. 36 (Blk. Twp.) 19 (Sur. Rge.) 8W Map No.

Operator Drillers Production

Well No. 1 Farm Knight

Elev. Location C S½ SE SW

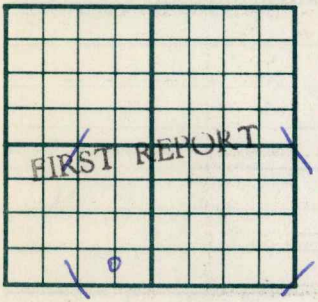

330 Ft. From S Line SW

660 Ft. From E Line Quarter

JAN 12 1955

1st. Report

Completion

Remarks Tom Allan - Contr.

Spudding Date

Drlg. Data Wildcat

Location

FABEN-GILSTRAP

FORM 275 FOR SALE BY KANSAS BLUE PRINT CO.


County Rice State Kansas

Sec. 36 (Blk. Twp.) 19 (Sur. Rge.) 8W Map No.

Operator Drillers Production

Well No. 1 Farm Knight

Elev. 1738 Location C S½ SE SW

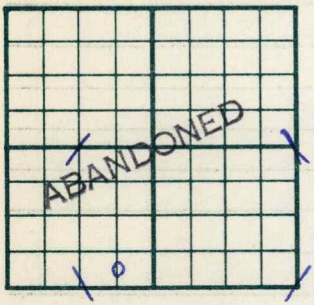

330 Ft. From S Line SW

660 Ft. From E Line Quarter

1st. Report

Completion FEB 2 1955

Remarks Wildcat

Tom Allan - Contr.

Spudding Date 1-13-55

Drlg. Data D & A TD 3415

8" @ 145 Tarkio 2086 Br. lime 2838

Lans. 2877 B KC 3186 Cong. 3198

Kh. 3212 Maq. 3354 Viola 3369

Simp. sh. 3405 Simp. dolo. 3409

TD 3415

D & A

FABEN GILSTRAP