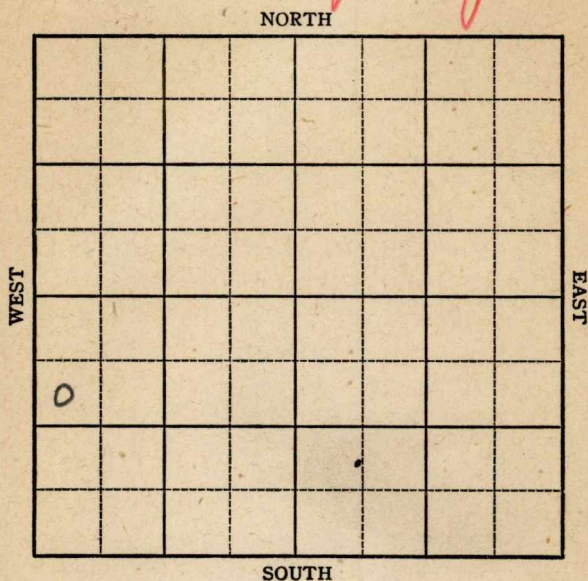


KANSAS

Rice county

Section 4 Township 19 Range 9-WWell No. #1, Grizzell "B"Company ~~D.R.M.~~ Darily sly

KANSAS

Rice✓

Sec. 4 Twp. 19 R. 9-W

Well No. #1, Grizzell "B" Farm


~~D.R.M.~~ DERBY DRUG Company
Chase Pool

990' Ft. from N. Line

_____ Ft. from S. Line

_____ Ft. from E. Line

330' Ft. from W. Line

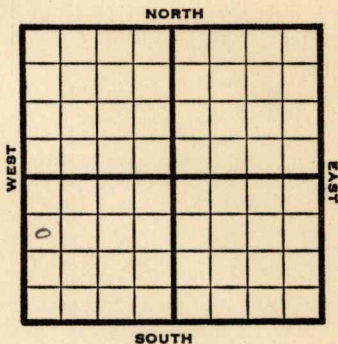

SW NW SW

	REPORT
1947	Elev. 1709'
1/22	8" @ 178' Drlg. 2100'
1/30	SD
2/5	Lans 2897' Arb. 323249-52 TD 3252' 5" @ 3249' RUST
2/12	" " "
2/19	Arb 3249' TD 3272'
	ABANDONED

Kansas
KANSASMap No. 49 Sec. 4 Twp. 19 R. 9WWell No. 1 Grizzell "B"

D. R. M.

Company

FIRST REPORT

Contractor

SW NW SW

SECTION PLAT

990 Ft. from N. Line Ft. from S. Line Ft. from E. Line330 Ft. from W. Line

Rice County

Location Rig up

Drilling and Remarks:

8" @ 178

drlg. 2100

RECORD

Cased in., ft.Sand Gas Oil Total Depth

PRODUCTION

1st 24 hrs. Nat. 1st 24 hrs. after shot Gas Cu. Ft.Dry Hole Abandoned

Date

JAN 22 1947

19

S. J. LEWIS

Scout

Map No. 49 Sec. 4 Twp. 19 R. 9W

Well No. 1 Grizzell "B"

Derby Drlg.

Company

CORRECTION

Contractor

SW NW SW

SECTION PLAT

990 Ft. from N. Line

 Ft. from S. Line

 Ft. from E. Line

330 Ft. from W. Line

o			

Rice County

Location

Rig up

Drilling and Remarks:

Changed name from
from D.R.M.

RECORD

Cased in., ft.

Sand

Gas

Oil

Total Depth

PRODUCTION

1st 24 hrs. Nat.

1st 24 hrs. after shot

Gas Cu. Ft.

Dry Hole

Abandoned

Date

FEB 5 1947

19

S. J. LEWIS

Scout

Kansas **KANSAS**Map No. 49 Sec. 4 Twp. 19 R. 9WWell No. 1 Grizzell "B"


Derby Drlg.

Company

ABANDONED

Contractor

SW NW SW

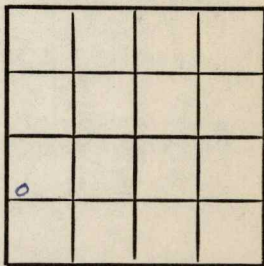E. 1/208
SECTION PLAT990 Ft. from N. Line Ft. from S. Line Ft. from E. Line330 Ft. from W. Line

Rice County

Location Rig up

Drilling and Remarks:

*288248***RECORD**Cased in., ft.Sand Gas Oil Total Depth 2272**PRODUCTION**1st 24 hrs. Nat. 1st 24 hrs. after shot Gas Cu. Ft.Dry Hole Abandoned

Date

FEB 19 1947S. J. LEWIS

Scout