

Rice


KANSAS

FORM 51 5M PETROL

Section 4 Township 19 Range 9W

Well No. 1 Grizzell "D"

Company D. R. M.

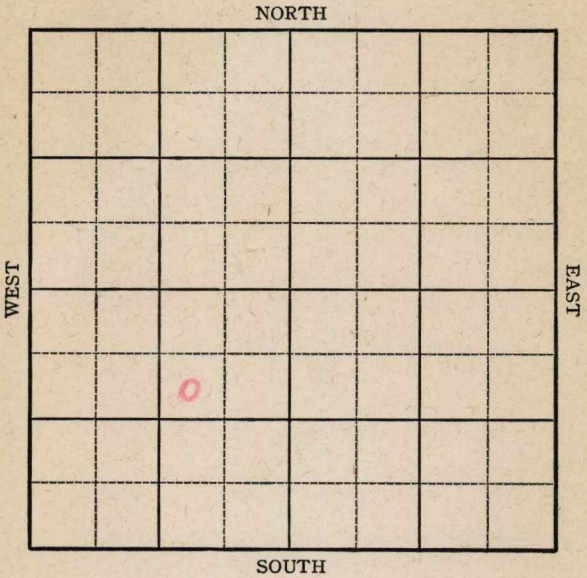

KANSAS

Rice

Sec. 4 Twp. 19 R. 9W

Well No. 1 Grizzell "D" Farm

D.R.M. _____ Company


Chase

990 Ft. from N. Line

_____ Ft. from S. Line

990 Ft. from E. Line

_____ Ft. from W. Line

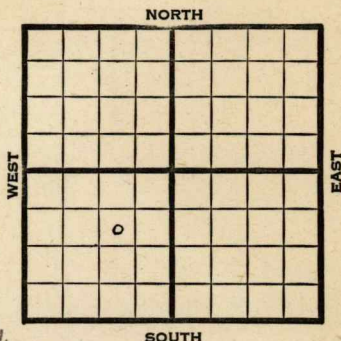

SW NE SW Eley. 1734

1945

REPORT

6/20	RUR
6/28	10" @ 200
	Anhy 387
7/3	Drlg. 1634
	Topeka 2494
	Lans 2921
	Drlg. 3095
7/11	Arb. 3279-3280
	TD 3280
	5" @ 3279' RUST
7/19	Swab 1 oil plus 11 wtr per hr. 11 hrs.
7/26	" " " " " "
8/1	" " " " " "
8/8	" " " " " "
8/15	Pump 247 wtr. plus 12 oil a day
8/22	" " " " " "
8/29	" " " " " "
9/5	" " " " " "
9/12	" " " " " "
9/19	" " " " " "
9/26	Arb. 3279
	5" @ 3279
	TD 3280
	Pump 247 wtr. plus 22 oil Pot.
	Grav. 42.0

COMPLETED

Kansas Pool Name ChaseMap No. 49 Sec. 4 Twp. 19 R. 9WWell No. 1 Grizzell "D"D. R. M.


Company

FIRST REPORT

Contractor

SW NE SW

SECTION PLAT

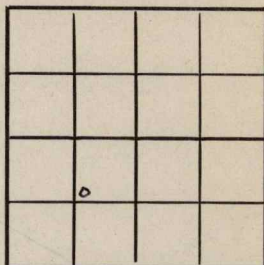990 Ft. from N. Line Ft. from S. Line990 Ft. from E. Line Ft. from W. LineRice CountyLocation Rig up

Drilling and Remarks:

RUR

RECORD

Cased in., ft.Sand Gas Oil Total Depth

PRODUCTION

1st 24 hrs. Nat. 1st 24 hrs. after shot Gas Cu. Ft.Dry Hole Abandoned

Date

JUN 20 1945 19 S. J. LEWIS Scout

KANSASKansas Pool Name ChaseMap No. 49 Sec. 4 Twp. 19 R. 9WWell No. 1 Grizzell "D"


D. R. M.

Company

COMPLETED

Contractor

SW NE SW

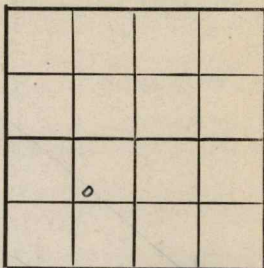E 1/734
SECTION PLAT990 Ft. from N. Line Ft. from S. Line990 Ft. from E. Line Ft. from W. Line

Rice County

Location Rig up

Drilling and Remarks:

Cs + 32795' 03278Jump 24' water+ 22 oil Rd42° S**RECORD**Cased in., ft.Sand Gas Oil Total Depth 3280**PRODUCTION**1st 24 hrs. Nat. 1st 24 hrs. after shot Gas Cu. Ft.Dry Hole Abandoned

Date

SEP 26 1945 19S. J. LEWIS

Scout