


Rice

Form 51—5M—5-34—Palace

Map No. **KANSAS** Sec. *25* Twp. *19* R. *8 W*

Well No. *1 Taylor* Farm
Darby Pitt et al Company

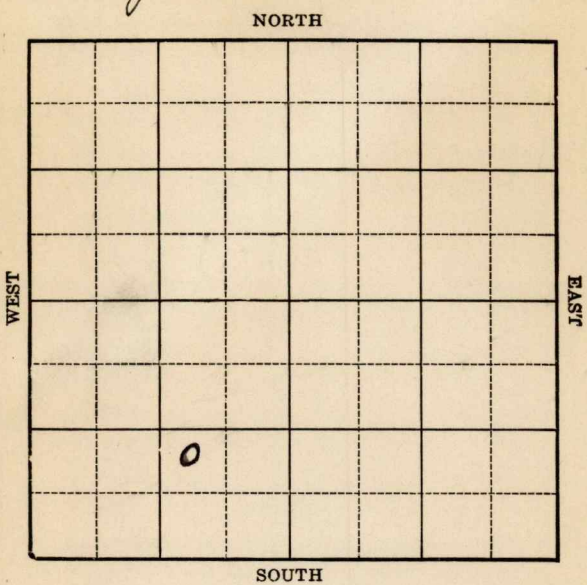

Location _____
Drilling Remarks _____

Rig Up _____
Drilling Remarks _____

RECORD

Cased _____ in. _____ ft.
Sand _____
Gas _____
Oil _____
Total Depth _____

PRODUCTION

1st 24 hrs. Nat. _____
1st 24 hrs. after shot _____
Gas _____ cu. ft. _____
Dry Hole _____
Abandoned _____

Rice

Map No. **KANSAS** Sec. 25 Twp 19 R. 8^W


Well No. 1 Taylor Farm
Darby Pet et al Company

 Ft. from N. Line

990 Ft. from S. Line

 Ft. from E. Line

1650 Ft. from W. Line

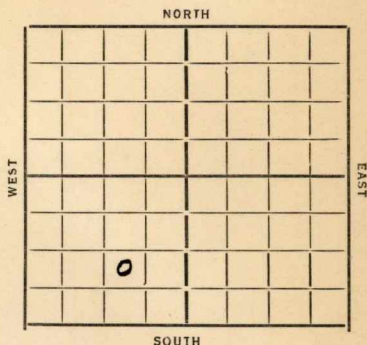

Date 1934

REPORT

7/25 Rig
8/2 Spud 200 20" 82'
8/9 dly 1220 15" 275
8/16 Show gas 1520-25 13" 1688
dly 1970
8/23 " 2650 10" 2615
8/30 10" 2747 57 2752
9/6 — 9/13 — 9/20 —
9/27 8" 2856 Lansing 2863
HFW 3000-15 W.R. 8"
10/4 8 1/4 3018 S.O. & W. 3185
dly 3204
10/11 Uela 3368 Wilex 3430
HFW 3413 6" 3417 1200' W
3431-33 dly 3448
10/17 Siliceous 3468 TD 3552
D & F

ABANDONED

KANSAS

Map No. 49 Sec. 25 Twp. 19 R. 8WWell No. 1-TaylorDarby pit et al Company

Contractor

FIRST REPORTS

SECTION PLAT

	0		

____ Ft. from N. Line

990 Ft. from S. Line

____ Ft. from E. Line

1650 Ft. from W. Line

Location _____

Rig up _____

Drilling and Remarks:

RECORD

Cased _____ in., _____ ft.

Sand _____

Gas _____

Oil _____

Total Depth _____

PRODUCTION

1st 24 hrs. Nat. _____

1st 24 hrs. after shot _____

Gas _____ Cu. Ft.

Dry Hole _____

Abandoned _____

Date

ORVAL MANNSCHRECK

Scout

19

KANSAS

Map No. 49 Sec. 25 Twp. 19 R. 8WWell No. 1-TaylorHarby et al CompanyABANDONED Contractor

SECTION PLAT

	0		

____ Ft. from N. Line

990 Ft. from S. Line

____ Ft. from E. Line

1650 Ft. from W. Line

Location _____

Rig up _____

Drilling and Remarks:

10 + ft

RECORD

Cased _____ in., _____ ft.

Sand siliceous 3468

Gas _____

Oil _____

Total Depth 3552

PRODUCTION

1st 24 hrs. Nat. _____

1st 24 hrs. after shot _____

Gas _____ Cu. Ft.

Dry Hole _____

Abandoned _____

Date

10-17-31 19 _____
ORVAL MANNSCHRECK
Scout