


Rice

Section 3 Township 19 S KANSAS Range 9 W
Well No. # 1 Keller
Company Henry Bennett et al

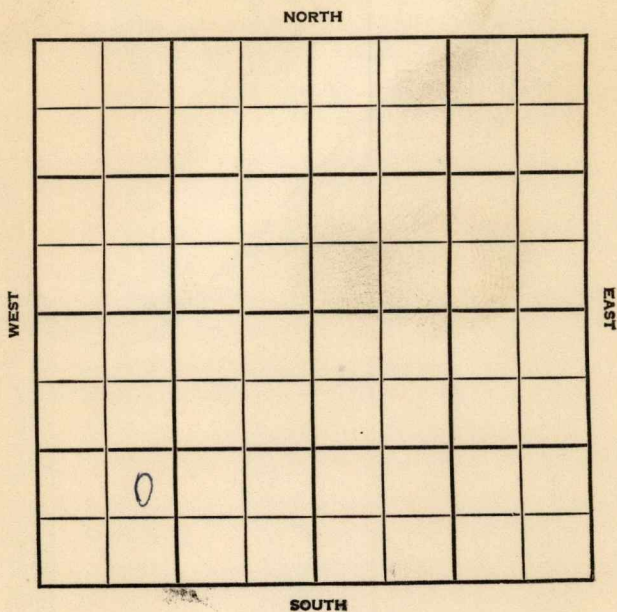

Rice

KANSAS

SEC.	TWP.	R.
3	19 S	9 W

WELL NO.

1 Keller

FARM

COMPANY

Henry Bennett et al

CONTRACTOR

Bedell-Catt

Chase-Silica

Ft. from N. Line

990


Ft. from S. Line

Ft. from E. Line

990

Ft. from W. Line

NE SW SW

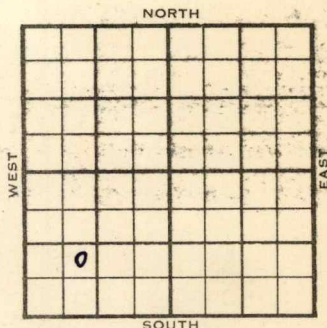

1954

ELEVATION

1709'

REPORT

12/8

C & P (Start moving next week)

12/29

Spud 12-14-54

8" @ 130'

Lans 2904'

B KC 3193' Cong 3249'

TD 3270'

D & A

ABANDONED

County Rice State Kansas
 Sec. 3 (Blk.) 19 (Sur.) 9W Map No.
 Operator Henry Bennett etal.
 Well No. 1 Farm Keller
 Elev. 1709 Location NE SW SW (twin)



990Ft. From S Line SW
990Ft. From W Line Quarter
 1st. Report
 Completion DEC 29 1954
 Remarks Chase-Silica Pool
Bedell- Catt - Contr.
 Spudding Date 12-14-54

Drlg. Data

8" @ 130 Lans. 2904 B KC 3193

Cong. 3249 TD 3270

D & A

FABEN GILSTRAP