

Rice


Form 51-5M-5-34-Palace

Map No. **KANSAS** Sec. 4 Twp. 19 R. 9W

Well No. 1- Hinzell Farm

Shell Pet. Company

NORTH

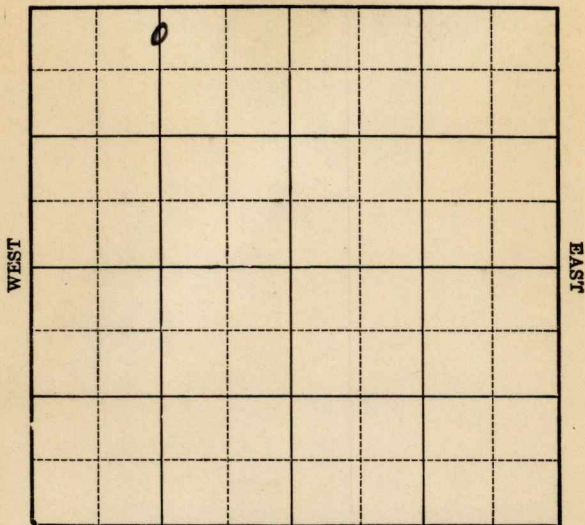

Location _____

Drilling Remarks _____

Rig Up _____

Drilling Remarks _____

RECORD

Cased _____ in. _____ ft.

Sand _____

Gas _____

Oil _____

Total Depth _____

PRODUCTION

1st 24 hrs. Nat. _____

1st 24 hrs. after shot _____

Gas _____ cu. ft.

Dry Hole _____


Abandoned _____

Rice

Map No. **KANSAS** Sec. 4 Twp. 19 R. 9W

Well No. 1 Grizzell Farm
Shell Pet. Company

440 Ft. from N. Line
 Ft. from S. Line
1326 Ft. from E. Line
 Ft. from W. Line
1702

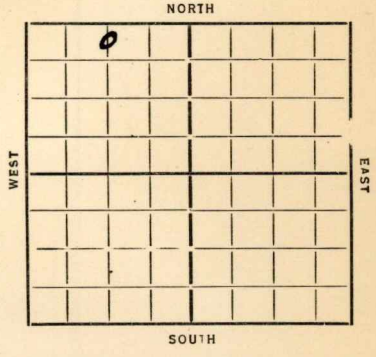

Date	REPORT
7/20	Rot. Rig
2/28	Log 759
3/7	" 2148
3/14	MC 2875 2921 Coring
3/21	Log 3241
3/28	Log 3264 Sil 3264 T 1) 3270
4/4	Core 3318 1050' Sub Water
4/10	Siliceous 3267 T 1) 3318
	170 FT.

ABANDONED

Map No. 49 Sec. 4 Twp. 19 R. 9W

Well No. 1-Grizzell

Shell pit Company

Contractor

FIRST REPORTS

SECTION PLAT

440 Ft. from N. Line

..... Ft. from S. Line

1326 Ft. from E. Line

..... Ft. from W. Line

KANSAS

Location.....

Rig up.....

Drilling and Remarks:

Rot Rig

RECORD

Cased..... in., ft.

Sand.....

Gas.....

Oil.....

Total Depth.....

PRODUCTION

1st 24 hrs. Nat.....

1st 24 hrs. after shot.....

Gas..... Cu. Ft.

Dry Hole.....

Abandoned.....

Date

2-20-35 192.....

ORVAL MANNSCHRECK
Scout

Map No. 49 Sec. 4 Twp. 19 R. 9W

Well No. 1-Priggell

shell pit etal Company

Contractor

ABANDONED

SECTION PLAT

440 Ft. from N. Line

Ft. from S. Line

1326 Ft. from E. Line

Ft. from W. Line

0			

Location

Rig up

Drilling and Remarks:

NO + A

RECORD

Cased _____ in., _____ ft.

Sand siliceous 3267

Gas _____

Oil _____

Total Depth 3318

PRODUCTION

1st 24 hrs. Nat. _____

1st 24 hrs. after shot _____

Gas _____ Cu. Ft.

Dry Hole _____

Abandoned _____

Date

4-10-35 192

ORVAL MANNSCHRECK

Scout