


Section 5 Township 19 Range 9 W

Well No. # 2 Grizzell

Company Lewis Drlg.

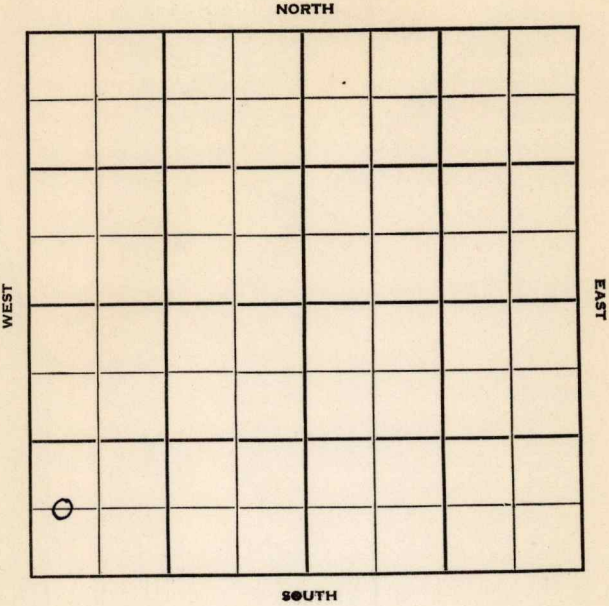

Rice

KANSAS

Sec. 5 Twp. 19 R. 9 W

Well No. # 2 Grizzell Farm

Lewis Drlg.

Company

Lewis Drlg.

Contractor

Chase Pool

Ft. from N. Line

660


Ft. from S. Line

Ft. from E. Line

330

Ft. from W. Line

C W L SW SW

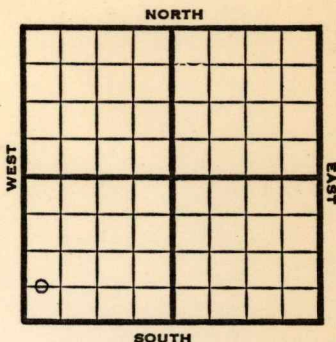

1951

Elev. 1707'

REPORT

5/2

Spud 4-24-51

8" @ 197

Anhy 355'

Drlg. 3140'

6/13

Spud 4-24-51

Oil well TD 3271' 8" @ 197

Anhy 355' Heeb 2738' Br. lime 2862'

Lans. 2887' Arb. 3243-46

5" @ 3244 TD 3254' 2 GOPH

500 A DD 3260 no inc. DD 3268'

DD 3271' FU 150' fluid 9 hr. 50%

water. PB 2987' 64/2949-65

8 BWPH PB 2930 40/2907-17

1000 A 4 1/2 BFPH 50% water

Comp. 35 BOPD 35 BW

COMPLETED

County **Rice** State **Kansas**Sec. **5** (Blk.) **19** (Sur. Rge.) **9W** Map No.Operator **Lewis Drlg.**Well No. **2** Farm **Grizzell**Elev. Location **C W L SW SW**

660 Ft. From **S** Line **SW****330** Ft. From **W** Line Quarter1st. Report **MAY 2 1951**

Completion

Remarks

Lewis Drlg. - Contr.Spudding Date **4-24-51**Drlg. Data **Chase Pool****8" @ 197 Anhy 355 drlg. 3140**

J. E. TYRA

County	Rice		State	Kansas	
Sec.	5	(Blk. Twp.)	19	(Sur. Rge.)	9W Map No.
Operator	Lewis Drlg.				
Well No.	2	Farm	Grizzell		
Elev.	1707	Location	C W L SW SW		
			660 Ft. From	S Line	SW
			330 Ft. From	W Line	Quarter
			1st. Report		
			Completion JUN 13 1951		
			Remarks Chase Pool		
			Lewis Drlg. - Contr.		
			Spudding Date 4-24-51		
Drlg. Data		Oil well	TD 3271		
8" @ 197		Anhy	355	Heeb. 2738	
Br. lime		2862	Lans. 2887		
Arb. 3243-46		5" @ 3244	TD 3254		
2 goph		500 A	DD 3260 no inc.		
DD 3268		DD 3271	FU 150' fluid		
9 hr.		50% water	PB 2987	64/ 2949	
65		8 bwph	PB 2930	40/ 2907-17	
1000 A		4½ bfph	50% water		
Comp. 35 bopd		35 bw			

J. E. TYRA