

KANSAS

Rice

FORM 51 5M 10-41 PETROL

Section 5 Township 19 Range 9-W

Well No. #1 Grizzell "C"

Company McPherson Drlg.

Chase Pool

NORTH

WEST

EAST

0

SOUTH

KANSAS


Rice

Sec. 5 Twp. 19 R. 9-W
Well No. #1 Grizzell "C" Farm
McPherson Drlg. Company

(Chase)

 Ft. from N. Line330 Ft. from S. Line990 Ft. from E. Line Ft. from W. Line

Elev. 1705

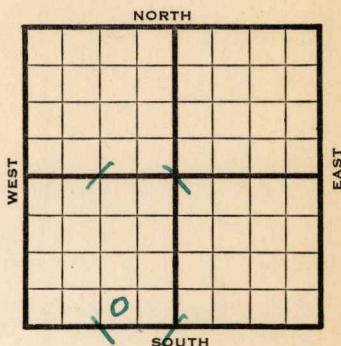

1942	REPORT
7/8	Derrick.
7/15	"
7/22	10" @ 163 Drlg. 1796'
7/29	Drlg. 2795'
8/5	Lans. 2893 Cong. 3240 Arb. 3287-95 T.D. S.D.
8/12	Abr. 3289 corrected 5" @ 3090 TD 3317 Rust.
8/19	35 shots 2905-11 to acidize.
8/27	Acidize 5000'
9/2	Shut down 5000'
9/9	Pump 100 Temp. Pot.
9/16	Arb. 3289 5" - 3090 Lans. 2893 35 shots 2905-11 5000 acid Flow 100 Pot. TD 3317 Gravity 44.

COMPLETED


Rice

KANSAS

Map No. 49 Sec. 5 Twp. 19 R. 9WWell No. 1 Grizzell "C"McPherson Drlg. CompanyFIRST REPORT Contractor

SW SE SW

SECTION PLAT

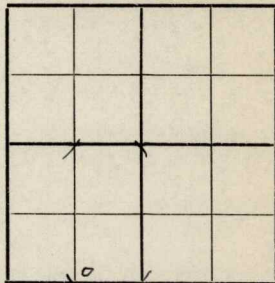 Ft. from N. Line330 Ft. from S. Line990 Ft. from E. Line Ft. from W. Line

CHASE POOL

Location Rig up

Drilling and Remarks:

Derrick

RECORD

Cased in., ft.Sand Gas Oil Total Depth

PRODUCTION

1st 24 hrs. Nat. 1st 24 hrs. after shot Gas Cu. Ft.Dry Hole Abandoned

Date

JUL 8 1942 19S. J. LEWIS Scout

Rice

KANSAS

Map No. 49 Sec. 5 Twp. 19 R. 9WWell No. 1 Grizzell "C"McPherson Drilling CompanyCOMPLETED Contractor

SW SE SW

SECTION PLAT

Ft. from N. Line

330 Ft. from S. Line990 Ft. from E. Line

Ft. from W. Line

CHASE POOL

Location _____

Rig up _____

Drilling and Remarks:

Ac Y 32895" @ 30901 and 289335 x 1/2 to 2905-115000 acidFlow 100 AY44 @ 4

RECORD

Cased _____ in., _____ ft.

Sand _____

Gas _____

Oil _____

Total Depth 3212

PRODUCTION

1st 24 hrs. Nat. _____

1st 24 hrs. after shot _____

Gas _____ Cu. Ft.

Dry Hole _____

Abandoned _____

Date

SEP 16 1942

19

S. J. LEWIS

Scout