

KANSAS


FORM 51 5M 4-41 PETROL

Rice

Section 5 Township 19 Range 9W

Well No. #1 Keller

Company McPherson Drlg.

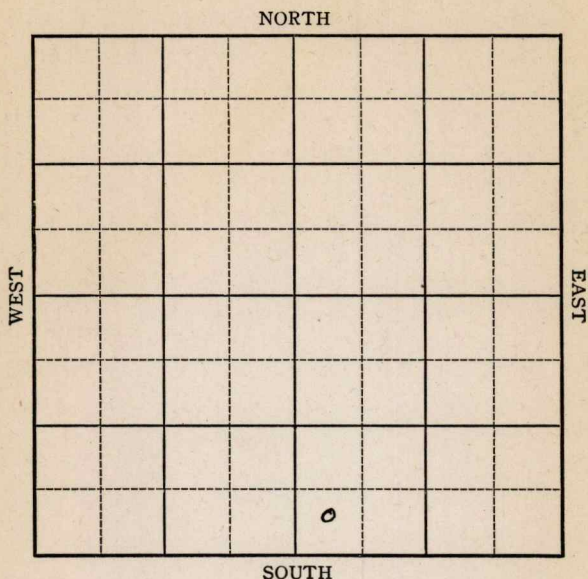


Sec. 5 Twp. 19 R. 9 1/2 WWell No. #1 Keller FarmMcPherson Drilling Company

(Semi-Wild cat)

 Ft. from N. Line330 Ft. from S. Line Ft. from E. Line330 Ft. from W. Line

Elev. 1706

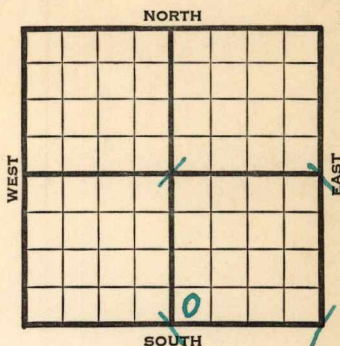

1941	REPORT
6/25	Location
7/3	Rotary.
7/10	10" - 157' Drlg. 2281'
7/17	Lans. 2900' Arb. 3330-38' T.D.
	5" - 3330' RUST.
7/24	" " " "
7/31	18 shots. 2913-28 3000 acid 2000' fluid 50% water SD
8/7	" " " " " "
8/15	To Re-perforate
8/21	" " "
8/28	" " "
9/4	Shut down.
9/10	Arb. 3330'
	5" - 3330'
	T.D. 3338'
	5600 acid.
	Water.
	ABANDONED

Map No. 49 Sec. 5 Twp. 19 R. 9WWell No. 1 KellerMcPherson Drilling Company

Contractor

FIRST REPORT

SW SE


Ft. from N. Line

330 Ft. from S. Line

Ft. from E. Line

330 Ft. from W. Line

SECTION PLAT

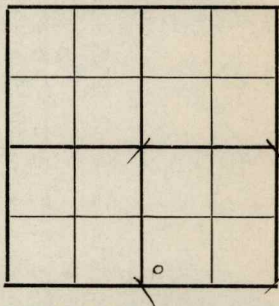

SEMI*WILDCAT

Location X

Rig up

Drilling and Remarks:

RECORD

Cased _____ in., _____ ft.

Sand _____

Gas _____

Oil _____

Total Depth _____

PRODUCTION

1st 24 hrs. Nat. _____

1st 24 hrs. after shot _____

Gas _____ Cu. Ft.

Dry Hole _____

Abandoned _____

Date

JUN 25 1941

19

S. J. LEWIS

Scout

Map No. _____ Sec. 5 Twp. 19 R. 9WWell No. 1 Keller_____McPherson Drilling Company_____ABANDONED Contractor

SECTION PLAT

_____SW SE
Ft. from N. Line_____330 Ft. from S. Line_____ Ft. from E. Line_____330 Ft. from W. Line

SEMI-WILDCAT

Location _____

Rig up _____

Drilling and Remarks:

Ar & 33305" @ 3330Water.5600 acid

RECORD

Cased _____ in., _____ ft.

Sand _____

Gas _____

Oil _____

Total Depth 3338

PRODUCTION

1st 24 hrs. Nat. _____

1st 24 hrs. after shot _____

Gas _____ Cu. Ft.

Dry Hole _____

Abandoned _____

Date

SEP 10 194119S. J. LEWIS

Scout