


Rice

Form 51-5M-2-29-34703

Map No. **KANSAS** Sec. 24 Twp. 19 R. 9w

Well No. 1-Murphy Farm
Shull Oil & Fuel Company

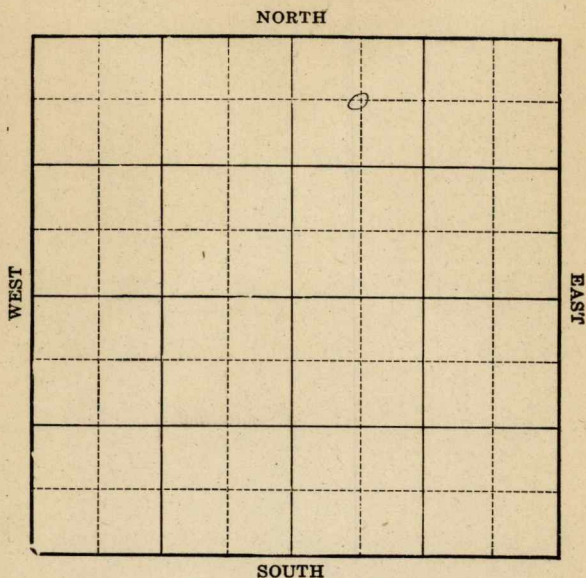

Location _____

Drilling Remarks _____

Rig Up _____

Drilling Remarks _____

RECORD

Cased _____ in. _____ ft.

Sand _____

Gas _____

Oil _____

Total Depth _____

PRODUCTION

1st 24 hrs. Nat. _____

1st 24 hrs. after shot _____


Gas _____ cu. ft.

Dry Hole _____

Abandoned _____

Map No. **KANSAS** Sec. 4 Twp. 19 R. 9^w
Well No. 1-Murphy Farm
Shell et al Company

NORTH

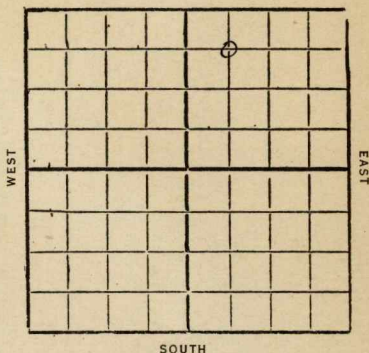660 Ft. from N. Line

Ft. from S. Line

Ft. from E. Line

660 Ft. from W. Line

SOUTH

Date

REPORT

6/22	MIM
6/29	Cur
7/6	
7/13	
7/20	15" 217 Dreg 1310'
7/27	" 2675'
8/3	Core green shale 3256-60 " Sand 3260-61 show oil Well run 8"
8/10	Cam 6"-3257
8/11	small show oil 3267 Top Dolomite 3269 HFW 3270-72 SD 3272'
8/17	TD 3272 HFW and est 5 bbl oil per day Will deepen
8/24	SD 3330' in line

8/31 Top Dolomite 3269
HF W 3270-72
TD 3330½'
Abandon

Rice

W

49 KANSAS

Map No. _____ Sec. 4 Twp. 19 R. 9

Well No. 1

Murphy

Shell et al

Company

Contractor

FIRST REPORTS

SECTION PLAT

		0	

660 Ft. from N. Line

_____ Ft. from S. Line

_____ Ft. from E. Line

660 Ft. from W. Line

Location _____

Rig up _____

Drilling and Remarks:

Moving in Water

RECORD

Cased _____ in., _____ ft.

Sand _____

Gas _____

Oil _____

Total Depth _____

PRODUCTION

1st 24 hrs. Nat. _____

1st 24 hrs. after shot _____

Gas _____ Cu. Ft.

Dry Hole _____

Abandoned _____

Date

JUN 22 1932

CHAS. L. SHERWOOD

192

Scout

Price

KANSAS

Map No. _____ Sec. 4 Twp. 19 R. 9 ^WWell No. 1 MurphyShell pet oil Company

Contractor

COMPLETED

660 Ft. from N. Line

_____ Ft. from S. Line

_____ Ft. from E. Line

660 Ft. from W. Line

ABANDONED

SECTION PLAT

		o	

Location _____

Rig up _____

Drilling and Remarks:

Top Dolomite 3269
HFW 3270-72

RECORD

Cased _____ in., _____ ft.

Sand _____

Gas _____

Oil _____

Total Depth 3330 1/2

PRODUCTION

1st 24 hrs. Nat. _____

1st 24 hrs. after shot _____

Gas _____ Cu. Ft.

Dry Hole ☒Abandoned ☒

Date

AUG 3 1 1932

192

CHAS. L. SHERWOOD

Scout