


# KANSAS Rice

Section 5 Township 19 Range 9W

Well No. 6 Keller

Company Henderson Oil

Chase  
NORTH

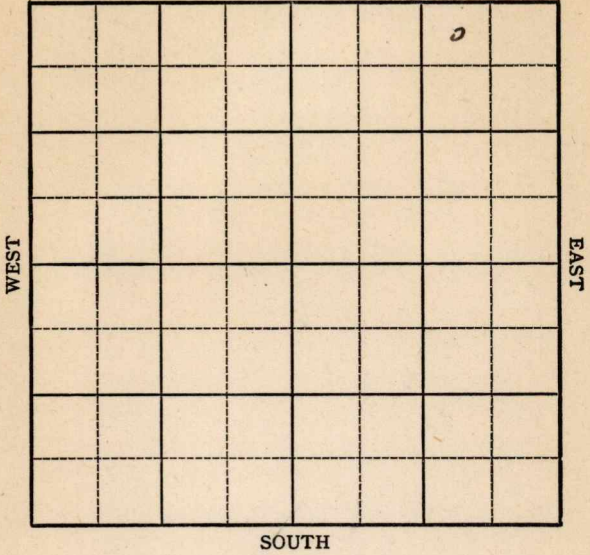

**KANSAS**

Sec. 5 Twp. 19 R. 9W ✓


Well No. #6 Keller Farm

Henderson Oil Company

Chase Pool

NORTH

330' Ft. from N. Line

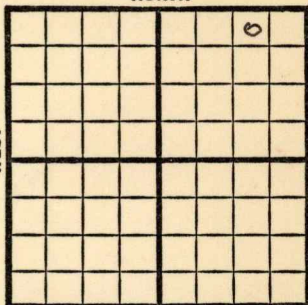

\_\_\_\_\_ Ft. from S. Line

990' Ft. from E. Line

\_\_\_\_\_ Ft. from W. Line

NW NE NE

SOUTH

1949 Elev 1723' REPORT

4/6 8" @ 190'

Drlg. 1560'

4/12 Lansing 2895'

BKC 3183'

Arb. 3242-48

TD 3248'

5" @ 3242'

"

4/20

4/27 TD 3249'

Pump 18 bbls oil 8 hrs.

5/4 500 acid

5/11 TD 3249'

Arb. 3242'

5" @ 3242'

500 acid

Pump 25 Oil Pot

42° Gr.

Comp

**COMPLETED**

Map No. \_\_\_\_\_ Sec. 5 Twp. 19 R. 9W

Well No. 6 Keller

Henderson Oil Company

FIRST REPORT Contractor

NW NE NE

SECTION PLAT

330 Ft. from N. Line

\_\_\_\_\_ Ft. from S. Line

990 Ft. from E. Line

\_\_\_\_\_ Ft. from W. Line

			0

Rice County

Location \_\_\_\_\_

Rig up \_\_\_\_\_

Drilling and Remarks:

8" @ 190

drlg. 1560

RECORD

Cased \_\_\_\_\_ in., \_\_\_\_\_ ft.

Sand \_\_\_\_\_

Gas \_\_\_\_\_

Oil \_\_\_\_\_

Total Depth \_\_\_\_\_

PRODUCTION

1st 24 hrs. Nat. \_\_\_\_\_

1st 24 hrs. after shot \_\_\_\_\_

Gas \_\_\_\_\_ Cu. Ft.

Dry Hole \_\_\_\_\_

Abandoned \_\_\_\_\_

Date

APR 6 1949 19

S. J. LEWIS

Scout

Kansas

Map No. 249 Sec. 5 Twp. 19 R. 9W

Well No. 6 Keller

Henderson Oil Company

**COMPLETE** Contractor

NW NE NE

*E. 1723*  
**SECTION PLAT**

330 Ft. from N. Line

\_\_\_\_\_ Ft. from S. Line

990 Ft. from E. Line

\_\_\_\_\_ Ft. from W. Line

			6

Rice County

Location \_\_\_\_\_

Rig up \_\_\_\_\_

Drilling and Remarks:

*Cat 78242*  
*5" Cat 78242*  
*500 and*  
*Proy soil Rd*  
*422 1/2*

**RECORD**

Cased \_\_\_\_\_ in., \_\_\_\_\_ ft.

Sand \_\_\_\_\_

Gas \_\_\_\_\_

Oil \_\_\_\_\_

Total Depth 3248

**PRODUCTION**

1st 24 hrs. Nat. \_\_\_\_\_

1st 24 hrs. after shot \_\_\_\_\_

Gas \_\_\_\_\_ Cu. Ft.

Dry Hole \_\_\_\_\_

Abandoned \_\_\_\_\_

Date

MAY 11 1949 19

S. J. LEWIS Scout