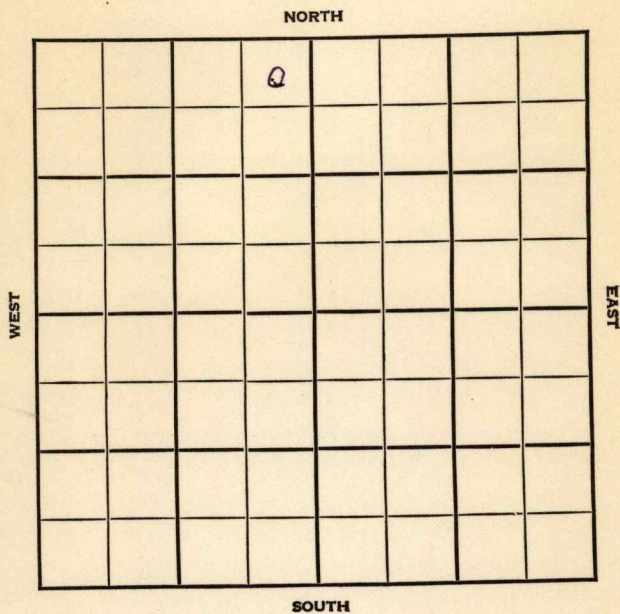


Section 5 Township 19 Range 9-WWell No. #4 Patton "E"Company Sohio etal

KANSAS

Rice

Sec. 5 Twp. 19 R. 9W

Well No. #4 Patton "E" Farm

Sohio et al

Company

Chase Pool


330' Ft. from N. Line

Ft. from S. Line

330' Ft. from E. Line

Ft. from W. Line

NE NW

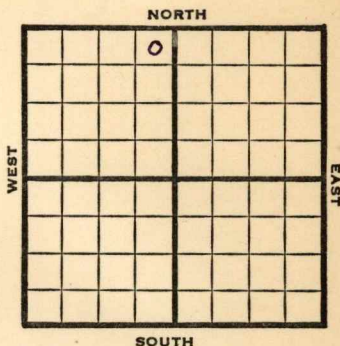

1948

REPORT

Eli 1714'

7/8

8" @ 312'

Drlg. 710'

7/14

Lansing 2884'

Arbuckle 3231

TD 3234'

5"@ 3232'

7/21

Swb $1\frac{1}{2}$ bbls oil PH 8 hrs.

7/28

Arb. 3231'

5"@ 3232'

TD 3234'

Pump 100 Oil Ppt

42° Gr.

Comp.

COMPLETED

Map No. _____ Sec. 5 Twp. 19 R. 9W

Well No. 4 Patton "E"

Sohio etal. Company

FIRST REPORT

Contractor

NE NW


SECTION PLAT

330 Ft. from N. Line

Ft. from S. Line

330 Ft. from E. Line

Ft. from W. Line

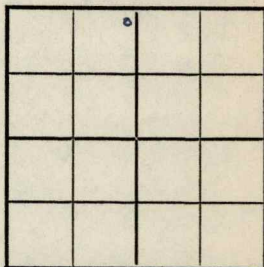

Rice County

Location _____

Rig up _____

Drilling and Remarks:

8" @ 312

drlg. 710

RECORD

Cased _____ in., _____ ft.

Sand _____

Gas _____

Oil _____

Total Depth _____

PRODUCTION

1st 24 hrs. Nat. _____

1st 24 hrs. after shot _____

Gas _____ Cu. Ft.

Dry Hole _____

Abandoned _____

Date

JUL 8 1948 19 S. J. LEWIS Scout

Rice County Kansas State

Map No. 49 Sec. 5 Twp. 19 R. 9W

Well No. 4 Patton "E"

Sohio etal. Company

COMPLETE

Contractor

NE NW

E. 1/4

SECTION PLAT

330 Ft. from N. Line

 Ft. from S. Line

330 Ft. from E. Line

 Ft. from W. Line

		0			

Chase Pool

Remarks:

Ac 83231

5 "03232

AD3234

Pump 10001 2d

42 2/3

Date

Scout

JUL 28 1948

S. J. LEWIS

