

KANSAS


Rice

Section 5 Township 19 Range 9W

Well No. 5 Patton "E"

Company Sohio et al

Chase Pool
NORTH

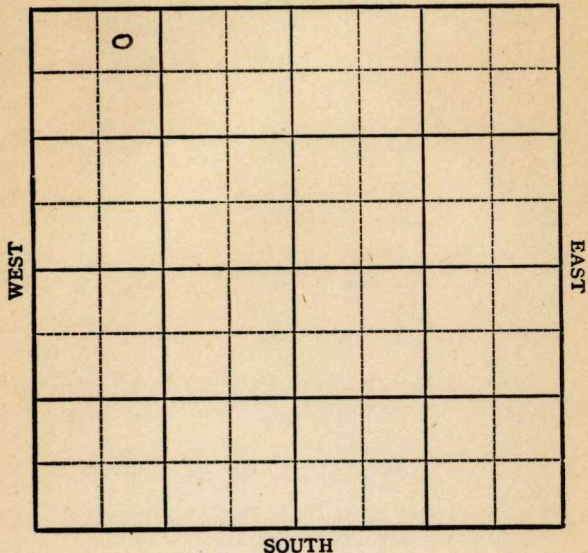

KANSAS

Rice

Sec. 5 Twp. 19 R. 9W ✓

Well No. #5 Patton "E" Farm _____

Sohio et al

Company

Chase Pool


330' Ft. from N. Line

_____ Ft. from S. Line

_____ Ft. from E. Line

990' Ft. from W. Line

NE NW NW

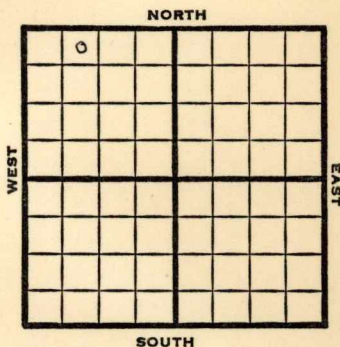

1948 **Eli 1712'** REPORT

11/10 Location
11/16 8" @ 210'
765
11/23 "
11/30 **Lansing 2891'**
Arbuckle 3229-38'
TD 3238'
5"@ 3231'
12/8 TD 3343'
Arb. 3229'
5"@ 3231'
500 acid
Pump 75 Oil Pot
420 Gr.
Comp

COMPLETED

Kansas

Chase Pool

Map No. _____ Sec. 5 Twp. 19 R. 9WWell No. 5 Patton "E"Sohio etal.

Company

FIRST REPORT

Contractor


NE NW NW

SECTION PLAT

330 Ft. from N. Line

_____ Ft. from S. Line

_____ Ft. from E. Line

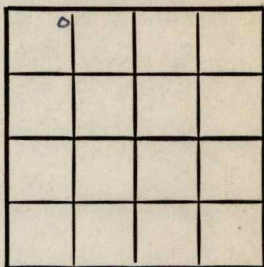990 Ft. from W. LineRice CountyLocation X

Rig up _____

Drilling and Remarks:

RECORD

Cased _____ in., _____ ft.

Sand _____

Gas _____

Oil _____

Total Depth _____

PRODUCTION

1st 24 hrs. Nat. _____

1st 24 hrs. after shot _____

Gas _____ Cu. Ft.

Dry Hole _____

Abandoned _____

Date

NOV 10 1948 19S. J. LEWIS

Scout

Kansas

Chase Pool

Map No. 49 Sec. 5 Twp. 19 R. 9WWell No. 5 Patton "E"

Sohio etal.

Company

COMPLETE

Contractor

NE NW NW

E1/7/2
SECTION PLAT

0			

330 Ft. from N. Line Ft. from S. Line Ft. from E. Line990 Ft. from W. Line

Rice County

Location Rig up

Drilling and Remarks:

*Per 83229**5" casing**5000 cu ft**Pump Oil Rod**42 2/3*

RECORD

Cased in., ft.Sand Gas Oil Total Depth 83243

PRODUCTION

1st 24 hrs. Nat. 1st 24 hrs. after shot Gas Cu. Ft.Dry Hole Abandoned

Date

DEC 8 1948 19

S. J. LEWIS Scout