


Rice

Section 5 Township 19 Range 9-W

Well No. 1 Reese "A"

Company E. V. Holland

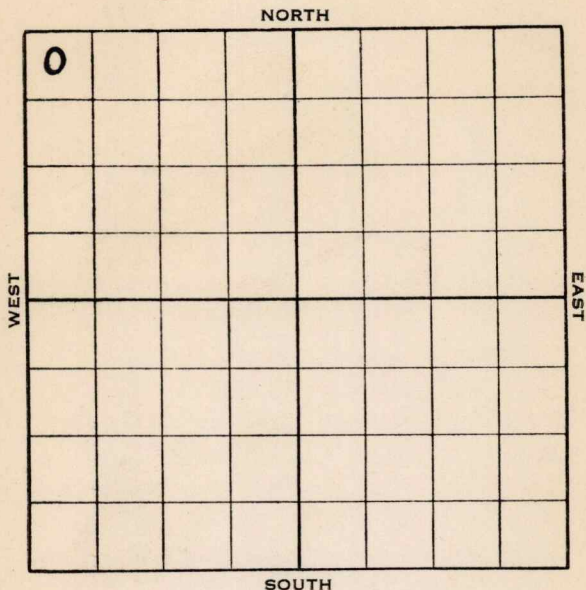

Sec. 5 Twp. 19 R. 9-W


Well No. #1 Reese "A" Farm  
E. V. Holland Company

330 Ft. from N. Line

\_\_\_\_\_ Ft. from S. Line

\_\_\_\_\_ Ft. from E. Line

330 Ft. from W. Line

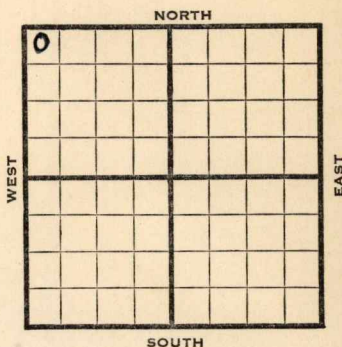

**Elev. 1711**

1938	REPORT
6/1	Cellar.
6/10	"
6/17	B.C.R.
6/24	R. U.
7/1	S.D.
7/8	Spud.
7/15	15" - 110'. <b>Anhy 370'.</b>
	12" - 786'. Dlg. 920'.
7/22	10" - 1555'. Dlg. 1818'.
7/29	Drlg. 2170'.
8/5	U. R. 8" - 2350'.
8/12	8" - 2369'. T.D. 2612'.
	U. R. 8" .
8/19	<b>Lans. 2870'.</b> 1½ M gas 2948-64'.
	6" - 2960'. Dlg. 2965'.
8/26	6" - 2992'. Dlg. 3038'.
9/2	S. O. 3044-48'. T. D. 3182'.
	U. R. 6" - 3115'.
9/9	Arb. <sup>3231</sup> <del>3228-40'</del> T. D.
	Pay <del>3235-40'</del> S. O.

**OVER**

1938

9/16

3240 equals 3248'.

Arb. 3231'. 7" - 3243'.

500' oil. Will acidize.

9/23

3000 acid. 800' oil. 2400' wtr.

9/28

7" at 3243'.

Arb. 3231'.

T. D. 3248'.

3000 acid.

H.F.W.

ABANDONED

Rice **KANSAS**

Map No. 49 Sec. 5 Twp. 19 R. 9W

Well No. 1 Reese "A"

E. V. Holland Company

Contractor

**FIRST REPORT**

NW/C

330 Ft. from N. Line

\_\_\_\_\_ Ft. from S. Line

\_\_\_\_\_ Ft. from E. Line

330 Ft. from W. Line

*Special*

**SECTION PLAT**

0			

Location \_\_\_\_\_

Rig up \_\_\_\_\_

Drilling and Remarks:

**Cellar**

**RECORD**

Cased \_\_\_\_\_ in., \_\_\_\_\_ ft.

Sand \_\_\_\_\_

Gas \_\_\_\_\_

Oil \_\_\_\_\_

Total Depth \_\_\_\_\_

**PRODUCTION**

1st 24 hrs. Nat. \_\_\_\_\_

1st 24 hrs. after shot \_\_\_\_\_

Gas \_\_\_\_\_ Cu. Ft.

Dry Hole \_\_\_\_\_

Abandoned \_\_\_\_\_

Date

JUN 1 - 1938 19

H. D. Hatfield

Scout

Map No. 49 Sec. 5 Twp. 19 R. 9W

Well No. 1 Reese "A"

E. V. Holland Company

Contractor

ABANDONED  
NW/C

SECTION PLAT

0			

330 Ft. from N. Line

\_\_\_\_\_ Ft. from S. Line

\_\_\_\_\_ Ft. from E. Line

330 Ft. from W. Line

Location \_\_\_\_\_

Rig up \_\_\_\_\_

Drilling and Remarks:

3000 acid

HFW

D & A

RECORD

Cased 7 in., 3243 ft.

Sand A-16 322.1

Gas \_\_\_\_\_

Oil \_\_\_\_\_

Total Depth 3248

PRODUCTION

1st 24 hrs. Nat. \_\_\_\_\_

1st 24 hrs. after shot \_\_\_\_\_

Gas \_\_\_\_\_ Cu. Ft.

Dry Hole \_\_\_\_\_

Abandoned \_\_\_\_\_

Date

SEP 28 1938 19

H. D. Hatfield Scout